

Pratt

KANSASSection 18 Township 27 Range 12WWell No. 2 - BurknerCompany Skelly Oil

NORTH

			0				

WEST

EAST

SOUTH

Pratt


KANSAS

Sec. 18 Twp. 27 R. 12 WWell No. # 2 Burkner FarmSkelly Oil Company

Contractor

990 Ft. from N. Line Ft. from S. Line330 Ft. from E. Line Ft. from W. Line

SE NE NW

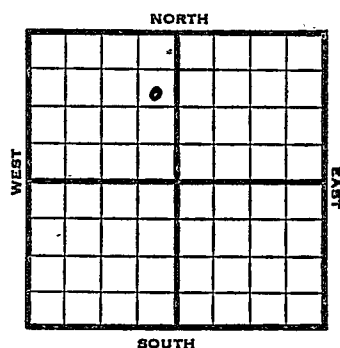

1953 Elev. 1847

REPORT

1/21 Location

1/29 8" @ 423'

2/5 Drlg. 3400'

2/12 Br li 3666, Lans 3684, Miss
 4121, V 4166, Simp sha 4216,
 Simp Dol 4232, Sd 4248
 G 4242-78, 45"
 Arb 4334
 Drlg. 4365

2/19 RTD 4483
 5" @ 4349'

2/26 CO 4337 30/4248 - 53 24/4255 - 59
 D - Hd

3/12 NR

3/19 NR

3/25 Spud 1-22-53

Oil Well

TD 4484

8" @ 423

Br Lime 3666, Lans 3684, Miss 4121,
 Viola 4166, Simp Sh. 4216, Simp dol.
 4232, Simp sd. 4248

Arb 4334,

TD 4484

OVER

1953

Information brought forward

3/25

5" @ 4349

CO to 4337

30/4248-53 24/4255-59 D-hydro.

SP 4244 17/4240-43 A-frac PB 4233

30/4225-30 1250 A PB 4200 138/4141-

84 D. hydro. CO to 4345 P/ 12

bo 5 bw 2 hr.

Comp. 137 bopd 4% wtr.

COMPLETED

County Pratt State Kansas

Sec. **18** (Blk. Twp.) **27** (Sur. Rge.) **12W** Map No.

Operator Skelly Oil

Well No. 2 Farm Burkner

Elev.	Location	SE NE NW
-------	----------	-----------------

0

FIRST REPORT

990 Ft. From N Line NW

330 Ft. From E Line Quarter

1st. Report JAN 21 1953

Completion

Remarks

Spudding Date _____

Drlg. Data


Location

Scout Cards	mm
Land Small Map	
Land Wall Map	B
Tracings	
France Map	
Piece Map	
Misc.	

JAN 26 1953

Orig. Data

County Pratt State Kansas
 Sec. 18 (Blk. 27) (Sur. 12W) (Twp. Map No.)
 Operator Skelly Oil
 Well No. 2 Farm Burkner
 Elev. 1847 Location SE NE NW

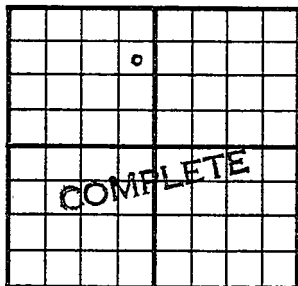

990 Ft. From N Line NW
330 Ft. From E Line Quarter

1st. Report

Completion MAR 25 1953

Remarks

Spudding Date 1-22-53

Drlg. Data Oil well TD 4484
8" @ 423 Br. lime 3666 Lans. 3684
Miss. 4121 Viola 4166 Simp. sh. 4216
Simp. dol. 4232 Simp. sd. 4248
Arb. 4334 TD 4484 5" @ 4349 CO to 4337
30/ 4248-53 24/ 4255-59 D-hydro.
SP 4244 17/ 4240-43 A-frac PB 4233
30/ 4225-30 1250A PB 4200 138/ 4141-84
D-hydro. CO to 4345 P/ 12 bo 5 bw 2 hr.
Comp. 137 bopd 4% wtr.

J. G. McGEHEE

APR 1 1953

Scout Cards	RR
Land Small Map	
Land Wall Map	5
Tracings	
France Map	
Pierce Map	
Misc	

Drig. Data