

FORM 51

Pratt

Section 18 Township 27 Range 12 WWell No. # 5 M. D. BurknerCompany Skelly Oil

NORTH

	0						

WEST

EAST


SOUTH

Pratt

KANSAS ✓

Sec. 18 Twp. 27 R. 12 WWell No. # 5 M. D. Burkner FarmSkelly Oil CompanyS. Iuka-Garmi Pool Contractor Ft. from N. Line330 Ft. from S. Line Ft. from E. Line990 Ft. from W. Line

SE SW NW

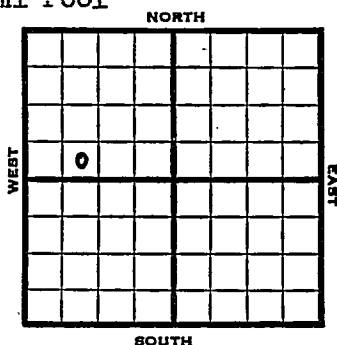

1953 Elev. 1873' REPORT

6/10 Location

6/24 8" @ 773'

7/1 Drlg. 2765'

7/8 Drlg. 3791'

7/22 N.R.

8/5 Spud 6-20-53 Oil well TD 4325'
 8" @ 773' Heeb 3507' Br lime 3681
 Lans 3699 Miss 4153' Viola 4198
 Simp. sh. 4248 Simp. dol. 4259'
 Simp. sd. 4272' TD 4325' 5" @ 4322
 CO to 4322 24/4305-09 48/4297-4305
 sd-oil-frac S/33 BO 2 BWFB
 S/6 BO $\frac{1}{2}$ BW 5 hr. PB 4294
 42/4286-93 S/4 BO $\frac{1}{2}$ BW 2 hr.
 CO to 4322
 Comp. 176 BOPD 14% wtr.

COMPLETED

County Pratt State Kansas
 Sec. 18 (Blk. 27 (Sur. 12W Map No.
 (Twp.) (Rge.)
 Operator Skelly Oil
 Well No. 5 Farm M. D. Burkner
 Elev. Location SE SW NW

FIRST REPORT									
0									

330 Ft. From S Line NW
990 Ft. From W Line Quarter
 Ist. Report JUN 10 1953
 Completion _____
 Remarks _____
 Spudding Date _____

Drlg. Data S. Iuka-Carmi Pool
 Location _____

J. G. McGEHEE