


Section 18 Township 27 Range 12W

Well No. #3 Burkner

Company Skelly Oil Company

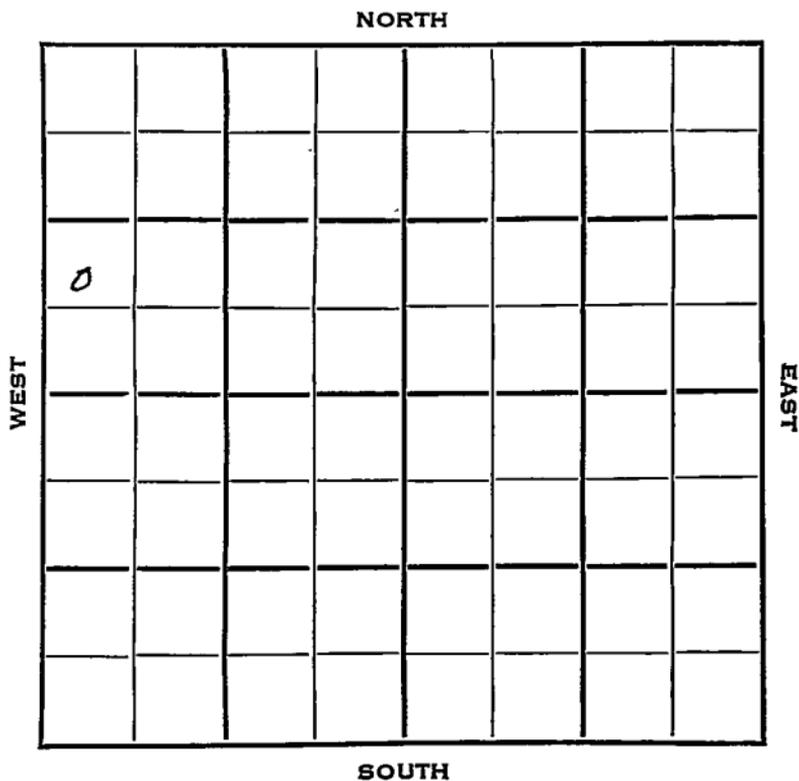

Sec. 18 Twp. 27 R. 12W

Well No. #3 Burkner Farm \_\_\_\_\_

Skelly Oil Company Company \_\_\_\_\_

Contractor \_\_\_\_\_


\_\_\_\_\_ Ft. from N. Line

990 Ft. from S. Line

\_\_\_\_\_ Ft. from E. Line

330 Ft. from W. Line

NW SW NW

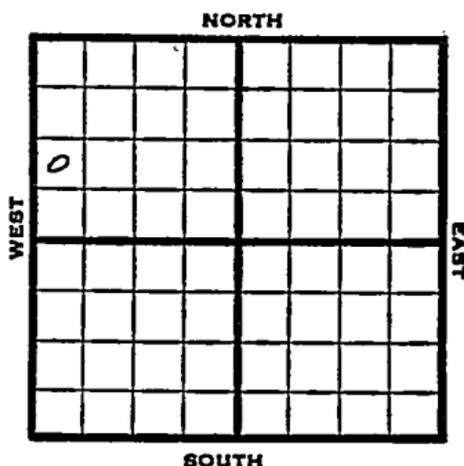

1953 Elev. 1892' REPORT

- 3/4 Location
- 3/12 8" @ 442'
- 3/19 Drlg. 3048'
- 3/26 Heeb 3531' Br li 3709' Lans 3725  
Miss li 4170' V 4210' Simp sha  
4260' Simp Dol 4271' Simp sd  
4285'
- 4/2 Cored 4283-4334 RTD 4334 5" @4334  
CO
- 4/9 18/4308-11,  
F 106 BO 1 hr., 48/4300-4308  
F 77 BO 50 mins  
F 73 BO 2½ hrs., 1/2" Ck
- 4/15 Spud 3-7-53  
Oil Well  
TD 4334'  
8" @ 442  
Heeb 3531, Br. Lime 3709, Lans 3725,  
Miss 4170, Viola 4210, Simp sh 4260,  
Simp dolo 4271, Simp. sd 4285  
TD 4334'  
5" @ 4334'  
CO to 4329  
18/ 4308-11 F/ 106 bo 1 hr.

OVER

1953

Information brought forward

4/15

"  
48/ 4300-08 F/ 77 bo 50 min.  
F/ 73 bo 2½ hr.  
Comp. 2249 bopd.

**COMPLETED**



Scout Cards  
 Land Small Map  
 Land Wall Map  
 Tracings  
 France Map  
 Pierce Map  
 Misc.....

MAR 6 1953

1953



APR 21 1953

Scout Cards  
Land Small Map  
Land Wall Map  
Tracings  
France Map  
Pierce Map  
Misc.

*PP*

Orig. Data