


Section 18 Township 27 Range 12W

Well No. #4 Burkner

Company Skelly Oil

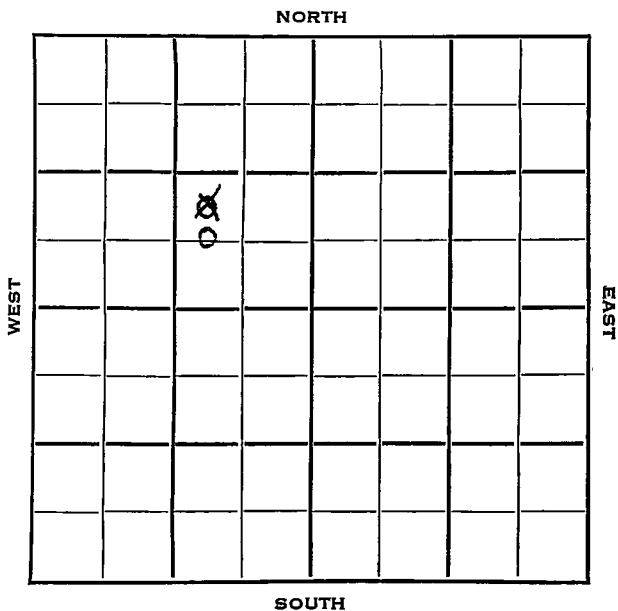



Sec. 18 Twp. 27 R. 12 W

Well No. # 4 Burkner Farm

Skelly Oil Company

Contractor

Iuka-Carmi Pool

Ft. from N. Line


~~990~~ 660 Ft. from S. Line

990 Ft. from E. Line

Ft. from W. Line

~~NW SE NW~~

2 WL SE NW

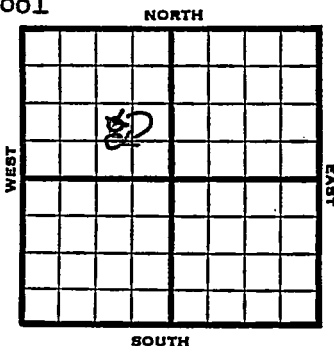

1953

Elev. 1871'

REPORT

4/8

Location

4/23 Br. L. 3684, Lans 3701, Miss 4157, V. 4194, Simp Shale 4238 Drlg 4258'

4/30 Simp sd. 4266,

TD 4317  
5" @ 4317'

5/7 CO 4314, 60/4273-83, 20 goph sd-oil-frac

F 20/64" Ck, 87 BO 5 hrs.

5/13 Spud 4-7-53 Oil well TD 4317  
8" @ 416 Br lime 3684 Lans 3701  
Miss 4157 Viola 4194 Simp 4238  
Simp. sd 4266 TD 4317' 5" @ 4317  
CO to 4314 60/4273-83 20 GOPH  
sd-oil-frac. F/87 BO 5 hr.  
Comp. 547 BOPD

**COMPLETED**

County Pratt State Kansas

Sec. 18 (Blk. 27 (Sur. 12W Map No. (Twp.) (Rge.))

Operator Skelly Oil

Well No. 4 Farm Burkner

Elev. \_\_\_\_\_ Location NW SE NW

<b>FIRST REPORT</b>			
0			
<i>[Handwritten signature]</i>			

990 Ft. From S Line NW

990 Ft. From E Line Quarter

Ist. Report 4-8-53

Completion \_\_\_\_\_

Remarks \_\_\_\_\_

Spudding Date \_\_\_\_\_

Drlg. Data Iuka-Carmi Pool

Location \_\_\_\_\_

Kansas

Map No. \_\_\_\_\_ Sec. 18 Twp. 27 R. 12WWell No. 4 Burkner\_\_\_\_\_Skelly Oil\_\_\_\_\_  
Company**CORRECTION**\_\_\_\_\_  
Contractor

C W L SE NW

## SECTION PLAT

\_\_\_\_\_  
Ft. from N. Line660  
Ft. from S. Line990  
Ft. from E. Line\_\_\_\_\_  
Ft. from W. Line

	o		

Pratt County

Location \_\_\_\_\_

Rig up \_\_\_\_\_

Drilling and Remarks:

Reported  
NW SE NW

## RECORD

Cased \_\_\_\_\_ in., \_\_\_\_\_ ft.

Sand \_\_\_\_\_

Gas \_\_\_\_\_

Oil \_\_\_\_\_

Total Depth \_\_\_\_\_

## PRODUCTION

1st 24 hrs. Nat. \_\_\_\_\_

1st 24 hrs. after shot \_\_\_\_\_

Gas \_\_\_\_\_ Cu. Ft.

Dry Hole \_\_\_\_\_

Abandoned \_\_\_\_\_

Date

APR 15 1953  
19

J. G. MCGEHEE

Scout

