

Section 18 Township 27 Range 12 WWell No. # 6 M. D. BurknerCompany Skelly Oil

0							

NORTH

WEST

EAST

SOUTH

Pratt

KANSAS ✓

Sec. 18 Twp. 27 R. 12WWell No. #6 M.D. Burkner FarmSkelly Oil

Company

Contractor

Iuka-Carmi Pool

330

Ft. from N. Line


Ft. from S. Line

Ft. from E. Line

330

Ft. from W. Line

NW NW SW

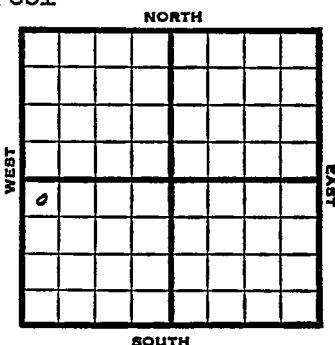

1953 Elev. 1890'

REPORT

7/1

Loc.

7/8

8" @ 762

7/22

Heeb 3530, Br. L. 3695, Lans 3715,
 B KC 4065, Marm 4094, Miss 4159, V.
 4219, Simp sho 4270. Simp dol. 4280
 Simp sd 4291
 RTD 4345
 5" @ 4345'

8/19

Spud 7-1-53

Oil Well

TD 4345

8" @ 762

Heeb 3530, Br lime 3695, Lans 3715,
 B KC 4065, Marm 4094, M, ss 4159,
 Viola 4219, Simp sh. 4270, Simp dol.
 4280, Simp sd 4291

TD 4345

5" @ 4345

CO to 4340 30/4325-30, 6 bo 6 bw
 4 hrs.

PB 4317, 30/4300-05, 2½ go 10 hrs.

Sd-oil-frac, F/20 bo 2 bw 12 hrs.

S/95 bo 10 bw 7 hrs., SP 4297

23/4292-96, S/98 bo 33 bw 18 hrs.

CO to 4317

Comp. 127 bopd 29% wtr.

COMPLETED

J. G. McGEHEE

J. G. McGEHEE