

Pratt


FORM 51

KANSAS

Section 18 Township 27 Range 12W

Well No. #7 M.D. Burkner

Company Skelly Oil

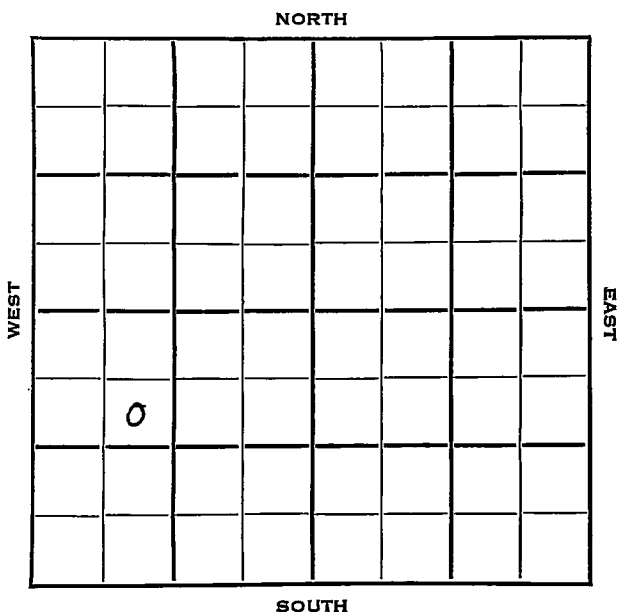

Pratt

KANSAS

Sec. 18 Twp. 27 R. 12WWell No. #7 M.D. Burkner FarmSkelly Oil Company

Contractor

Tuka-Carmi Pool


1035 Ft. from N. Line

Ft. from S. Line

Ft. from E. Line

980 Ft. from W. Line

SE NW SW

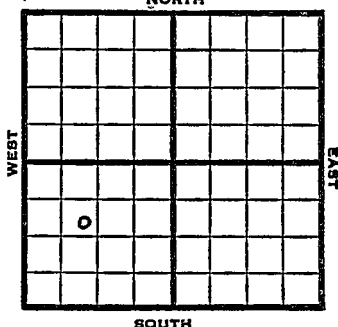

1953 Elev. 1882' REPORT

7/29 Spud 7-27-53

8/5 8" @ 403'

Drlg 2270'

8/12 Heeb 3519, Br. L. 3693, Lans3713

Drlg 4150'

8/19 Miss 4152, V 4200, Simp 4248, Simp
dol 4260

RTD 4328

5" @ 4328'

8/26 CO 4307, 24/4304-07, S/210 BO 15 hrs.
36/4298-4304, S/123 BO 9 hrs.9/2 57/ 4289-98 F 88 BO 3 BW 10 Hrs.
sd-o-frac F 103 BO 6 Hrs. 2" Tub.
24/64" Ck.

9/9 Spud 7-27-53

Oil Well

TD 4328'

8" @ 403'

Heeb 3519, Br. Lime 3693, Lans 3713,

Miss 4152, Viola 4200, Simp 4248, Simp

Dol 4260

TD 4328'

5" @ 4328'

OVER

1953

Information brought forward.

9/9

CO to 4307

24/ 4304-07 S/ 210 bo 15 hr.

36/ 4298'-4304 S/ 123 bo 9 hr.

57/ 4289-98

F/ 88 bo 3 bw 10 hr. sd-oil-frac.

F/ 103 bo 6 hr.

Comp. 3000 bopd.

COMPLETED

County Pratt State KansasSec. 18 (Blk. 27 (Sur. 12W Map No.Operator Skelly OilWell No. 7 Farm M. D. BurknerElev. Location SE NW SW


1035 Ft. From N Line SW980 Ft. From W Line Quarter1st. Report JUL 29 1953

Completion

Remarks

Spudding Date 7-27-53Drig. Data Iuka-Carmi Pool

J. G. McGEHEE

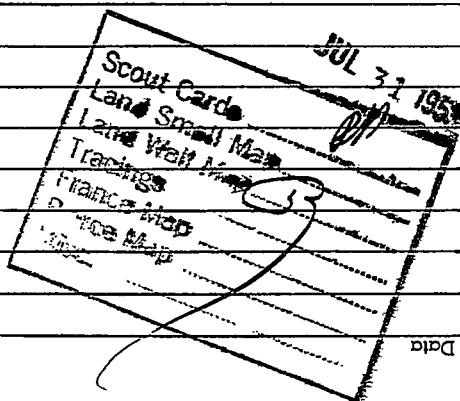

Drig. Data

County Pratt State Kansas

Sec. 18 (Blk. Twp.) 27 (Sur. Rge.) 12W Map No.

Operator Skelly Oil

Well No. 7 Farm M. D. Burkner

Elev. 1882 Location SE NW SW


1035 Ft. From N Line SW

980 Ft. From W Line Quarter

1st. Report

Completion SEP 9 1953

Remarks Iuka-Carmi Pool

Spudding Date 7-27-53

Drig. Data Oil well TD 4328

8" @ 403 Heeb. 3519 Br. lime 3693

Lans. 3713 Miss. 4152 Viola 4200

Simp. 4248 Simp. dol. 4260 TD 4328

5" @ 4328 CO to 4307 24/ 4304-07

S/ 210 bo 15 hr. 36/ 4298-4304

S/123 bo 9 hr. 57/ 4289-98

F/ 88 bo 3 bw 10 hr. sd-ohl-frac

F/ 103 bo 6 hr.. Comp. 3000 bopd

J. G. McGEHEE

SEP 15 1953

Scout Cards	
and Small Maps	
Land Wall Map	
Tracings	
France Map	
Pierce Map	
Misc.	

510