
FORM 51

Pratt KANSAS

Section 18 Township 27 Range 12 W

Well No. # 3 M. A. Justice

Company Skelly Oil

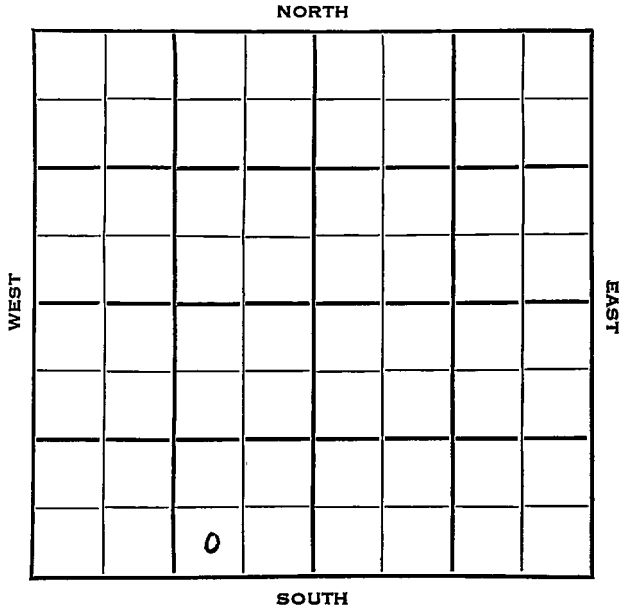

FORM 252-B

Pratt KANSAS ✓

Sec. 18 Twp. 27 R. 12W

Well No. #3 M. A. Justice Farm

Skelly Oil Company

Contractor

S. Iuka-Carmi Pool


Ft. from N. Line

330 Ft. from S. Line

990 Ft. from E. Line

Ft. from W. Line

SW SE SW

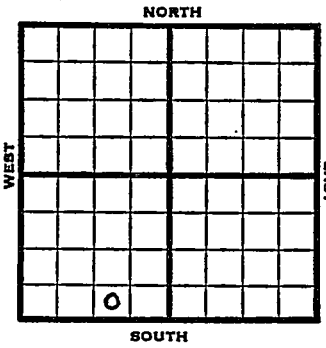

1953 Elev. 1882' REPORT

5/13 Spud 5-9-53
8" @ 753, WOC

5/21 Drlg 3364'

5/28 NR

6/3 Heeb 3537 Br li 3709 Lans 3731
Miss 4179 V 4220 Simp sh 4264
Simp sd 4279 RTD 4358 5" @ 4350
CO 4342 48/4311-19
F/180 BO 1-2/3 hrs.

6/10 F/87 BO 3 hrs 1/2" ck.
Sd-o-frac. F/89 BO 6 hrs 10/64" ck.

6/24 Spud 5-9-53
Oil Well
TD 4358
8" @ 753
Heeb 3537; Br lime 3709, Lans 3731,
Miss 4179, Viola 4220, Simp sh 4264,
Simp sd 4279
TD 4358
5" @ 4350, CO to 4342
48/4311-19, F/180 bo 1-2/3 hrs.
F/87 bo 3 hrs. sd-oil-frac
F/89 bo 6 hrs
Comp. 3000 bopd

COMPLETED

FORM 275 FOR SALE BY KANSAS BLUE PRINT CO.


County Pratt State Kansas

Sec. 18 (Blk. Twp.) 27 (Sur. Rge.) 12W Map No.

Operator Skelly Oil

Well No. 3 Farm M. A. Justice

Elev. Location SW SE SW

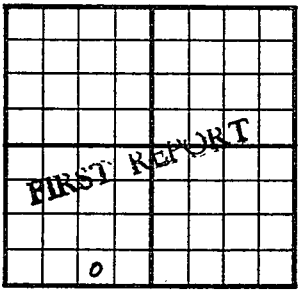

330 Ft. From S Line SW

990 Ft. From E Line Quarter

1st. Report MAY 1 3 1953

Completion

Remarks

Spudding Date 5-9-53

Drlg. Data S. Iuka-Carmi Pool

8⅝ @ 753 WOC

J. G. McGEHEE

FORM 275 FOR SALE BY KANSAS BLUE PRINT CO.


County Pratt State Kansas

Sec. 18 (Blk. / Twp.) 27 (Sur. / Rge.) 12W Map No.

Operator Skelly Oil

Well No. 3 Farm M. A. Justice

Elev. 1882 Location SW SE SW

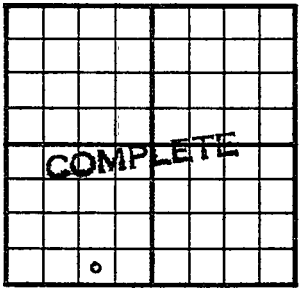

330 Ft. From S Line SW

990 Ft. From E Line Quarter

1st. Report

Completion JUN 24 1953

Remarks S. Iuka-Carmi Pool

Spudding Date 5-9-53

Drlg. Data Oil well TD 4358

8" @ 753 Heeb. 3537 Br. lime 3709

Lans. 3731 Miss. 4179 Viola 4220

Simp. sh. 4264 Simp. sd. 4279

TD 4358 5" @ 4350 CO to 4342

48/ 4311-19 F/ 180 bo 1 2/3 hr.

F/ 87 bo 3 hr. sd-oil-frac

F/ 89 bo 6 hr. Comp. 3000 bopd

J. G. McGEHEE