


Section 18 Township 27 Range 12W

Well No. 1 Seidel

Company Rine Drlg

Wildcat
NORTH

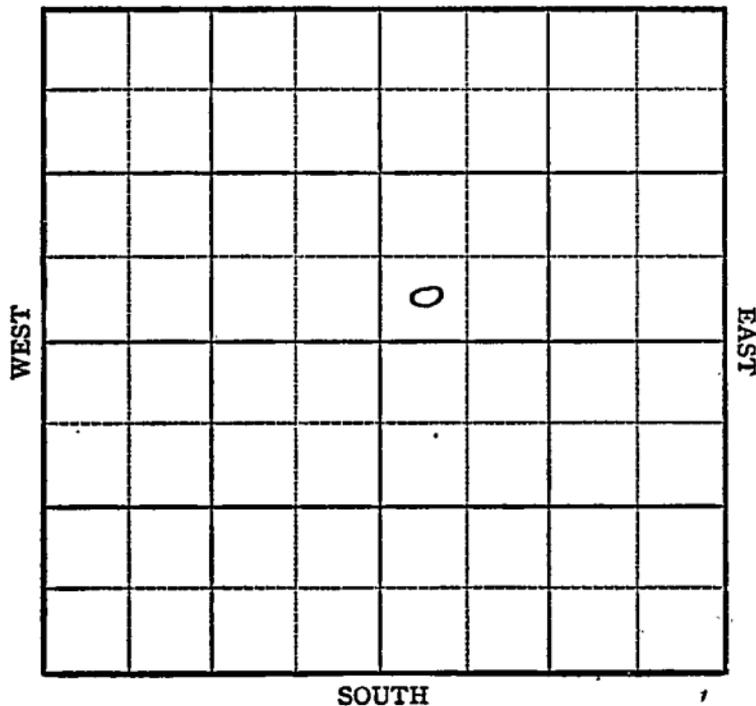

KANSAS

Pratt

12W

Sec. 18 Twp. 27 R.

Well No. #1 Seidel Farm

Rine Drlg. Company

Wildcat


_____ Ft. from N. Line

330' Ft. from S. Line

_____ Ft. from E. Line

330' Ft. from W. Line

SW NE

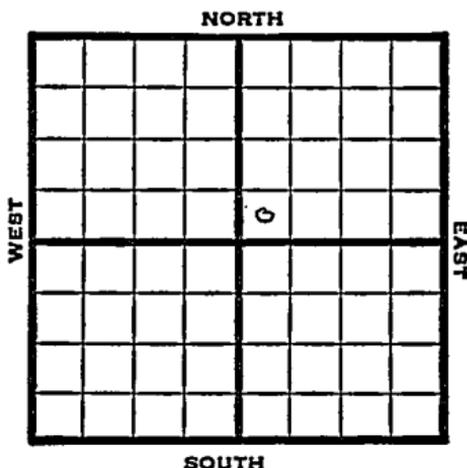

1949

Elev 1841' REPORT

2/2 Surface Hole

2/9 8" @ 353'
Drlg 3080'

2/16 Lansing 3684' Miss 4115'
Viola 4151' Simpson Sd 4238'
Drlg. 4252'

2/23 TD 4364'

3/1 5" @ 4343'
TD 4280'
Simp 4272' (Correct)
Aband.

ABANDONED

3/9 TD corrected to 4634'
well PB to 4280'

eod

KANSAS

Map No. _____ Sec. 18 Twp. 27 R. 12W

Well No. 1 Seidel

Rine Drlg. _____ Company

FIRST REPORT

Contractor

SW NE

SECTION PLAT

_____ Ft. from N. Line

330 Ft. from S. Line

_____ Ft. from E. Line

330 Ft. from W. Line

Pratt County.

Location _____

Rig up _____

Drilling and Remarks:

surface hole

RECORD

Cased _____ in., _____ ft.

Sand _____

Gas _____

Oil _____

Total Depth _____

PRODUCTION

1st 24 hrs. Nat. _____

1st 24 hrs. after shot _____

Gas _____ Cu. Ft.

Dry Hole _____

Abandoned _____

Date

FEB 2 1949 19

S. J. LEWIS

Scout

Map No. 157 Sec. 18 Twp. 27 R. 12W

Well No. 1 Seidel

Rinè Drlg.

Company

CORRECTION

Contractor

SW NE

SECTION PLAT

_____ Ft. from N. Line

330 Ft. from S. Line

_____ Ft. from E. Line

330 Ft. from W. Line

Pratt County

Location _____

Rig up _____

Drilling and Remarks:

Plugged back to
4280
total depth is
4634

RECORD

Cased _____ in., _____ ft.

Sand _____

Gas _____

Oil _____

Total Depth _____

PRODUCTION

1st 24 hrs. Nat. _____

1st 24 hrs. after shot _____

Gas _____ Cu. Ft.

Dry Hole _____

Abandoned _____

Date

MAR 9 1949

19

S. J. LEWIS

Scout

