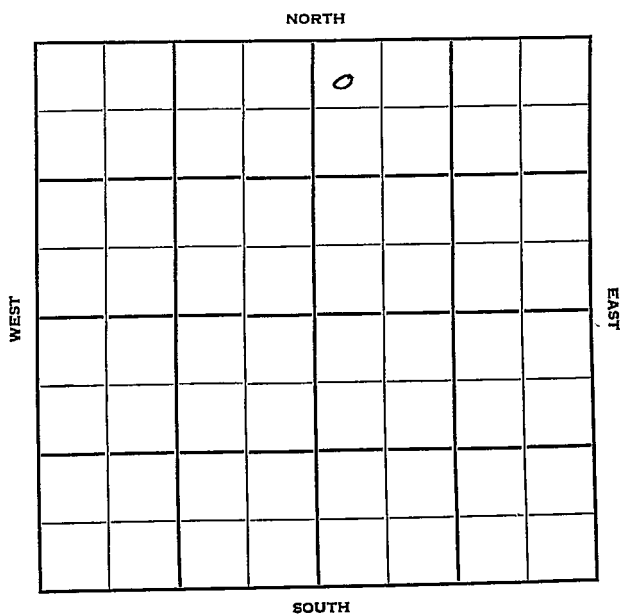


KANSAS

FORM 51 25M 3-49 PETROL Pratt

Section 18 Township 27 Range 12WWell No. #1 SeidelCompany Skelly Oil

Sec. 18 Twp. 27 R. 12W

Well No. #1 Seidel Farm

Skelly Oil

Company

Contractor

330

Ft. from N. Line


Ft. from S. Line

Ft. from E. Line

330

Ft. from W. Line

NW NW NE

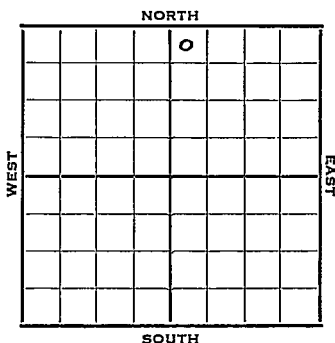

1952

Elev. 1853'

REPORT

9/24

Spud 9-17-52

8" @ 454'

Anhy 1010'

Drlg. 2187'

10/1

Drlg. 3950'

10/8

Br Li 3665

Lans. 3682

Miss. 4137

Viola 4165

Simp. sh 4209

Simp. 4218

Simp. sd 4231

F. 4222-80 Rec. 58' TD 4297'

10/15

CO to 4292 132/4248-70

F 172 BO 2 hrs.

10/22

D-Hyd. F/90 BO 4 hrs. 30/64" ck.

10/29

Spud 9-17-52

Oil Well TD 4297' 8" @ 454'

Anhy 1010

Br Li 3665

Lans. 3682

Miss. 4137

Viola 4165

Simp. sh 4209

Simp. 4218

Simp. sd 4231

TD 4297 5" @ 4296 CO to 4292

132/4248-70 F/172 bo 3 hr.

D-Hydro. F/90 bo 4 hr.

Comp. 3000 bopd

COMPLETED

County Pratt State Kansas
 Sec. 18 (Blk. Twp.) 27 (Sur. Rge.) 12W Map No. _____
 Operator Skelly Oil
 Well No. 1 Farm Seidel
 Elev. 1853 Location NW NW NE

				0		

FIRST REPORT

330 Ft. From N Line NE
 330 Ft. From W Line Quarter

1st. Report SFP 2 4 1952

Completion _____

Remarks _____

Spudding Date 9-17-52

Drlg. Data

8" @ 454 Anhy 1010 drlg. 2187


J. G. McGEHEE

County Pratt State Kansas
 Sec. 18 (Blk. 27 (Sur. 12W Map No.
 (Twp.) (Rge.)

Operator Skelly Oil

Well No. 1 Farm Seidel

Elev. 1853 Location NW NW NE

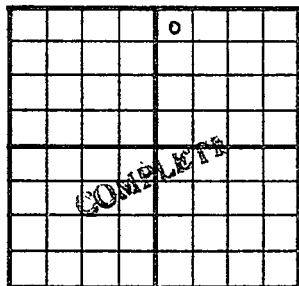

330 Ft. From N Line NE

330 Ft. From W Line Quarter

1st. Report

Completion OCT 29 1952

Remarks

Spudding Date 9-17-52

Drlg. Data Oil well TD 4297

8" @ 454 Anhy 1010 Br. lime 3665

lans. 3682 Miss. 4137 Viola 4165

Simp. sh. 4209 Simp. 4218 Simp. sd. 4231

TD 4297 5" @ 4296 CO to 4292 132/

4248-70 F/ 172 bo 3 hr. D-Hydro.

F/ 90 bo 4 hr. Comp. 3000 bopd

J. G. McGEHEE