

Kiowa

KANSAS

SECTION 5 TOWNSHIP 27 RANGE 19 W

WELL NO. #1 Hargadine "B"

COMPANY G-M-R Oil

NORTH

|  |  |  |  |  |  |  |   |
|--|--|--|--|--|--|--|---|
|  |  |  |  |  |  |  |   |
|  |  |  |  |  |  |  |   |
|  |  |  |  |  |  |  |   |
|  |  |  |  |  |  |  |   |
|  |  |  |  |  |  |  | 0 |
|  |  |  |  |  |  |  |   |
|  |  |  |  |  |  |  |   |
|  |  |  |  |  |  |  |   |

SOUTH

WEST

EAST

Kiowa

KANSAS

|      |      |      |
|------|------|------|
| SEC. | TWP. | R.   |
| 5    | 27   | 19 W |

WELL NO.

# 1 Hargadine "B"

FARM

COMPANY

~~GM~~ G-M-R Oil

CONTRACTOR

Co. tools


Wildcat

Ft. from N. Line

Ft. from S. Line

Ft. from E. Line

Ft. from W. Line

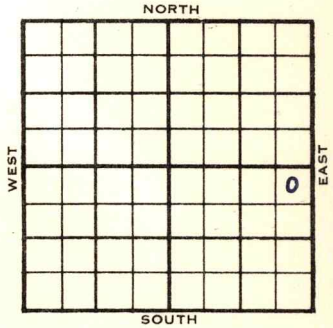

NE NE SE

SDX - 7/8 Mile

| 1955  | ELEVATION   | REPORT    |
|-------|---|-----------|
|       | 2260   |           |
| 12/7  | MIR   |           |
| 12-15 | Spud 12-7-55<br>8 5/8" @ 412/275<br>Drlg. 3435   |           |
| 12-22 | DST 4195-4212, op 1 hr. rec. 25' mud,<br>Br. lime 4192<br>Lans. 4196<br>DST 4309-21, op 1 hr. rec. 1440' msw,<br>1490#<br>Drlg. 4707'                                                                         |           |
| 12-28 | DST 4798-4813 op 2 hrs. gas in 28 min.<br>70 mcfg in 30 min., 29 mcfg in 1 hr.,<br># rec. 32' gcm, 1080/30"<br>DST 4814-37 op 1 hr. rec. 3200' o&gcs<br>1590#<br>D & A<br>Chert 4798<br>lime 4862<br>TD 4890' |           |
|       |   | ABANDONED |

County Kiowa Elev. \_\_\_\_\_  
Sec. 5 Twp. 27 Rge. 19W  
Company G-M-R Oil  
Farm Name Hargadine "B" No. 1

| TOPS   | DEPTH | LOG | DATUM |
|--------|-------|-----|-------|
| Anh.   |       |     |       |
| Tp.    |       |     |       |
| H.     |       |     |       |
| Tr.    |       |     |       |
| Dg.    |       |     |       |
| Bl.    |       |     |       |
| L.     |       |     |       |
| K.C.   |       |     |       |
| B.K.C. |       |     |       |
| Ce.    |       |     |       |
| C.     |       |     |       |
| M.     |       |     |       |
| M.     |       |     |       |
| K.     |       |     |       |
| Mz.    |       |     |       |
| Mq.    |       |     |       |
| V.     |       |     |       |
| S.     |       |     |       |
| S.     |       |     |       |
| A.     |       |     |       |
| R.     |       |     |       |
| Pe.    |       |     |       |
| G.     |       |     |       |
| T.D.   |       |     |       |

Loc. in Sec. NE NE SE  
Geol. \_\_\_\_\_  
Contr. \_\_\_\_\_  
Co. tools \_\_\_\_\_  
Pool Wildcat  
SDX- 7/8 mile  
FIRST REPORT  
DEC 7 '55

Date Comm. M I R  
25

County Kiowa Elev. 2260  
 Sec. 5 Twp. 27 Rge. 19W  
 Company G-M-R Oil  
 Farm Name Hargadine "B" No. 1

| TOPS            | DEPTH       | LOG | DATUM       | Loc. in Sec. |
|-----------------|-------------|-----|-------------|--------------|
| Anh.            |             |     |             | NE NE SE     |
| Tr.             |             |     |             |              |
| Dg.             |             |     |             |              |
| B.L.            | <u>4192</u> |     | <u>1932</u> |              |
| L.              | <u>4196</u> |     | <u>1936</u> | Geol.        |
| K.C.            |             |     |             | Contr.       |
| B.K.C.          |             |     |             | Co. tools    |
| Ce.             |             |     |             | Pool         |
| C.              |             |     |             | Wildcat      |
| M. <u>Chert</u> | <u>4798</u> |     | <u>2538</u> |              |
| M. <u>lime</u>  | <u>4862</u> |     | <u>2602</u> |              |
| K.              |             |     |             |              |
| Mz.             |             |     |             |              |
| Ma.             |             |     |             |              |
| V.              |             |     |             |              |
| S.              |             |     |             |              |
| S.              |             |     |             |              |
| A.              |             |     |             |              |
| R.              |             |     |             |              |
| Pe.             |             |     |             |              |
| G.              |             |     |             |              |
| T.D.            | <u>4890</u> |     |             |              |

Date Comm. 12-7-55 DEC 28 1955

8 5/8" @ 412/275 DST 4195-4212

open 1 hr. rec. 25' mud 160/20"

DST 4309-21 open 1 hr. rec. 1440' msw

1490# DST 4798-4813 open 2 hr.

gas in 28 min. 70 mcfg in 30 min.

29 mcfg in 1 hr. rec. 32' gcm 1080/30"

DST 4814-37 open 1 hr. rec. 3200' o &

gcsw 1590#

D & A

ABANDONED