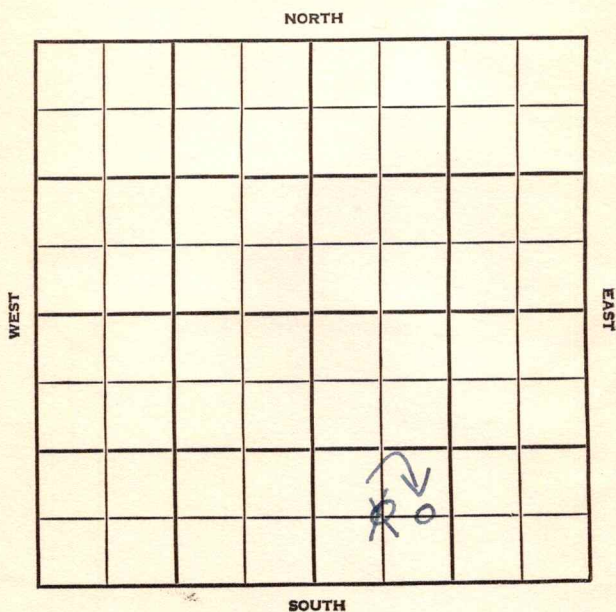


Section 15 Township 27 Range 19WWell No. #1 FarrarCompany Gramhart Miller & Newmont Oil

Kiowa

KANSAS

SEC.	TWP.	R.
15	27	19W

WELL NO.

1 Farrar

FARM

COMPANY

Gramhart Miller & Newmont Oil

CONTRACTOR

G-M-R


Wildcat

Ft. from N. Line

Ft. from S. Line

Ft. from E. Line

Ft. from W. Line

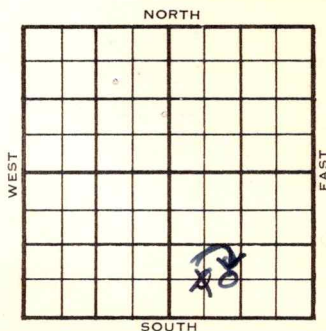

CE/2 SW SE

~~G SW SE~~

1955

ELEVATION

2244'

REPORT

6/22

Location

8/10

Comm 7/3/55

H 4032

Tr 4050

BL 4188

L 4192

4188

Ce

4762

M Cherb 4773

4773

TD 4840

4840

8 5/8" 535 w/300 DST 4188-98 1 hr rec

210' sgcm BHP 2000-20" DST 4282-4303

1 hr 240' sw BHP 1430/20"

DST 4763-88 90" gas in 15" ga 29 MCF

Rec 30' gcm BHP 1200/20" DST 4788-

4808 90" ga 191 mcf rec 30' HO & GCM

820' oil plus 330' SW BHP 1480/30"

DST 4801-08 90" gas in 10" ga 57

MCF 1020' oil plus 270' sw BHP 1490/

30" DST 3808-23 1 hr 900' gas plus

535' 0 & CCSW BHP 1550/30"

OVER

OVER

1955

8/10 DST 4788-4801 90" gas in 10" ga
125 M R 115 GCM BHP 1445/30"
5 1/2" 4804 CO 4804 16/4800-04 no
show re PF 16/4800-04 swb 20 gocmw (
(10% wtr) CO 4808 16/2804-08
swbl bo 3% wtr 1 hr swb 1 bo no wtr
2nd hr re PF 34/4804-08 gas to sur
immed. no ga ~~xxx~~ swb 26.80 bo plus
13.542 bw in 15 hrs plus est 50
mcfg Pmp 5 Bfph 40% wtr 3 hrs
Frac S/L lost load
D & A

ABANDONED

County Kiowa Elev. _____
Sec. 15 Twp. 27 Rge. 19W
Company Gramhart Miller & Newmont Oil
Farm Name Farrar No. 1

TOPS	DEPTH	LOG	DATUM
Anh.			
Tp.			
H.			
Tr.			
Dg.			
BL.			
L.			
K.C.			
B.K.C.			
Ce.			
C.			
M.			
M.			
K.			
Mz.			
Mq.			
V.			
S.			
S.			
A			
R.			
Pe.			
G.			
T.D.			

Loc. in Sec. C SW SE

Geol. _____

Contr. G-M-R

Pool Wildcat

FIRST REPORT
JUN 22 1955

Date Comm. _____
Location _____

X-25

County Kiowa Elev. 2244
 Sec. 15 Twp. 27S Rge. 19W
 Company Gramhart Miller & Newmont Oil
 Farm Name Farrar No. 1

TOPS	DEPTH	LOG	DATUM
Anh.			
T.P.			
H.	<u>4032</u>		<u>1788</u>
Tr.	<u>4050</u>		<u>1806</u>
Dg.			
B.L.	<u>4188</u>		<u>1944</u>
L.	<u>4192</u>	<u>4188</u>	
K.C.			
B.K.C.			
Ce.		<u>4762</u>	<u>2518</u>
C.			
M.	<u>Chert</u>	<u>4773</u>	<u>2529</u>
M.			
K.			
Mz.			
Mq.			
V.			
S.			
S.			
A.			
R.			
Pe.			
G.			
T.D.	<u>4840</u>	<u>4840</u>	

Loc. in Sec. C E/2 SW SE

Geol. _____

Contr. _____

G-M-R

Pool

Wildcat

AUG 1 - 1955
 ABANDONED

Date Comm. 7/3/55 8 5/8" 535 w/300 DST

4188-98 1 hr rec. 210' sgcm BHP 200/20"

DST 4282-4303 1 hr 240' SW BHP 1430/20"

DST 4763-88 90" gas in 15" ga 29MCF Rec

30' gcm BHP 1200/20" DST 4788-4808 90"

ga 191 mcf rec. 30' HO & GCM 820' oil

plus 330' SW BHP 1480/30" DST 4801-08

90" gas in 10" ga 57 MCF 1020' oil plus

270' sw BHP 1490/30" DST 3808-23 1 hr

900' gas plus 535' O & GCSW BHP 1550/30"

OVER

DST 4788-4801 90" gas in 10" ga 125 M R
115 GCM BHp 1445/30" 5½" 4840 CO 4804

16/4800-04 no show rePF 16/4800-04 swb
20 gocmw (10% wtr) CO 4808 16/2804-08
swbl bo 3% wtr 1 hr swb 1 bo no ~~lwx~~ wtr
2nd hr rePF 34/4804-08 gas to sur immed.

no ga. swb 26.80 bo plus 13.42 bw in 15 hrs
plus est 50 mcfg

Pmp 5 bfph 40% wtr 3 hrs

Frac S/L lost load

D & A

_____	Misc.
_____	Pierce Map
_____	France Map
_____	Tracings
_____	Land Wall Map
_____	Land Small Map
_____	Scout Cards

mm ~

AUG 18 1955

SCOUT TICKET

DX-201

Kansas

SEC.

TWP.

R.

15

27

19W

WELL NO.

/

Farrar

FARM

COMPANY

Gramhart Miller & Newmont Oil

CONTRACTOR

C E $\frac{1}{2}$ SW SE

CORRECTION


NORTH

_____ FT. FROM N. LINE

660 _____ FT. FROM S. LINE

_____ FT. FORM E. LINE

990 _____ FT. FROM W. LINE

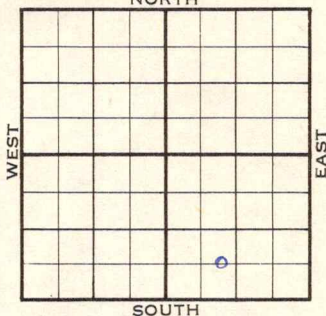

Kiowa County

☐

LOCATION

☐

RIG UP

DRILLING AND REMARKS:

Reported

C SW SE

RECORD

CASED IN., FT.

SAND

GAS

OIL

TOTAL DEPTH

PRODUCTION

1ST 24 HRS. NAT.

1ST 24 HRS. AFTER SHOT

GAS CU. FT.

DRY HOLE

ABANDONED

DATE

SCOUT

JUL 6 1955

L. J. Harris