


DX 78-1 Kiowa

KANSAS

Section 11 Township 27 Range 19W

Well No. #1 Miller

Company Purcell-Mull

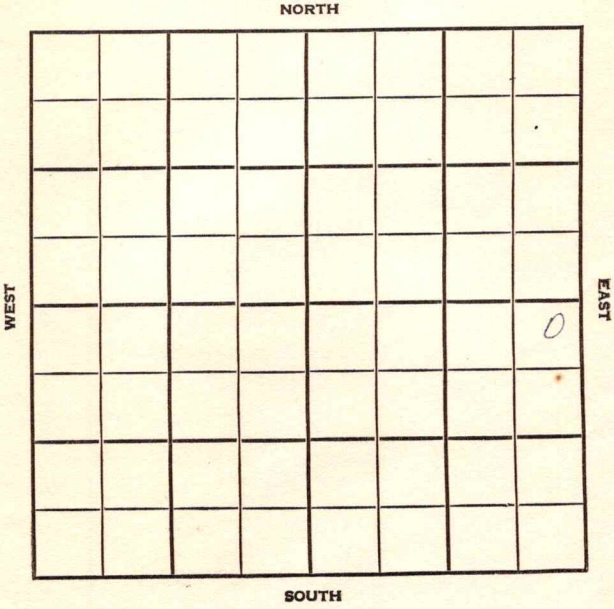

Kiowa

KANSAS

SEC.	TWP.	R.
11	27	19 W

WELL NO.

1 Miller

FARM

COMPANY

Purcell-Mull

CONTRACTOR

G-M-R

Wildcat


Ft. from N. Line

Ft. from S. Line

Ft. from E. Line

Ft. from W. Line

NE NE SE

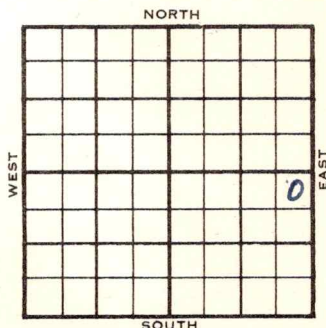

SDX - 1/2 Mile. Gramehart-Miller - FO

	ELEVATION	REPORT
1956	2240 DF	
3/21	Comm. 3-19-56 Drlg. 300'	
3-29	8 5/8" @ 408/466 Anhy 672 Drlg. 3740	
4-5	Heeb. 4056 Br. lime 4206, Lans. 4213 Miss. 4796 DST 4775-4805, op 2 hrs. gas in 55 min, 480 rec 55' drlg. mud, 920/20" DST 4806-20, op 2 hrs. rec. 50' socm, 80/20" Drlg. ahead	
4-11	DST 4820-45 op 55 min. rec. 30' mud, 0# D & A K. 4918 TD 4932'	

ABANDONED

County Kiowa Elev. 2240 DF
 Sec. 11 Twp. 27 Rge. 19W 2243 KB
 Company Mull Drlg.
 Farm Name Miller No. 1

TOPS	DEPTH	LOG	DATUM
Anh.	672		
Tp.			
H.	4056		
Tr.			
Dg.			
BL.	4206		
L.	4213		1973
K.C.			
B.K.C.			
Ce.			
C.			
M.	4796		2556
M.			
K.	4918		2678
Mz.			
Mq.			
V.			
S.			
S.			
A			
R.			
PE.			
G.			
T.D.	4932		

Loc. in Sec. _____

NE NE SE

Geol. _____

Contr. _____

G-M-R

Pool

Wildcat

ABANDONED

Date Comm. 3-19-56 APR 11 19568 5/8" @ 408/466 DST 4775-4805open 2 hr. gas in 55 min. rec. 55'drlg. mud 920/20" DST 4806-20open 2 hr. rec. 50' socm 80/20"DST 4820-45 open 55 min. rec. 30' mudOffD & A

County **Kiowa** Elev. _____
 Sec. **11** Twp. **27** Rge. **19W**
 Company **Purcell-Mull**
 Farm Name **Miller** No. **1**

TOPS	DEPTH	LOG	DATUM	Loc. in Sec.
Anh.				NE NE SE
Tp.				
H.				
Tr.				
Dg.				
B.L.				
L.				Geol. _____
K.C.				Contr. _____
B.K.C.				G-M-R
Ce.				Pool _____
C.				Wildcat
M.				
M.				
K.				
Mz.				
Me.				
V.				
S.				
S.				
A.				
R.				
Pe.				
G.				
T.D.				

Date Comm. **3-19-56** **Gramehart-Miller FO**
 drlg. 300

FIRST REPORT

SDX- 1/2 mile
 MAR 21 1956

25