


Section 27 Township 27 Range 19W

Well No. #1 Woods

Company Graham-Michaelis & Larry Stubbs

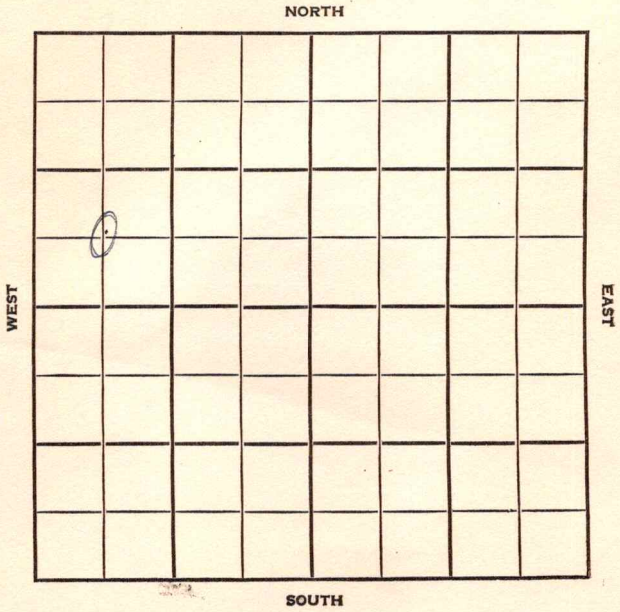

County Kiowa Elev. 2262
 Sec. 27 Twp. 27 Rge. 19W
 Company Graham-Michaelis & Larry Stubbs
 Farm Name Woods No. 1

TOPS	DEPTH	LOG	DATUM	Loc. in Sec.
Anh.				C SW NW
Tr.				
H.		4048		
Tr.		4069		
Dg.		4082		
Bl.	4200	4204		
L.	4207	4212		
K.C.				Geol.
B.K.C.		4566		Contr.
Ce.				G-M Tools
C.				
M.	4804	4807		Pool
M.				Wildcat
K.	Burlington chert	4876		
Mz.				
Ma.				
V.				
S.				
S.				
A.				
R.				
PE.				
G.				
T.D.	4905			



Date Comm. spd. 11-6-56 ^{5 Kelly DHM} Gulf (DHM) NOV 13 '56
8 5/8 320/250 @ 3400 NOV 21 '56
DST 4416-46 1 hr 20' Md FP
0 BHP 255/20" @ 4650 NOV 22 '56
DST 4804-15 @ 90" 6/24" ga 56 MCF rec 85'
GCM FPO-100 BHP 1496/20" DST 4816-30
6/64 ga 132 MCF rec 135' GCM FP 90400
BHP 1505/30" DST 4831-40 @ 1 hr
210' GRS rec-30' OCM + 60' OCSW + 200'
SW FP 140-200 BHP 1425 DE'A