

Kingman

Form 51-5M-11-31-Palace

Map No. **KANSAS** Sec.

Twp.

R.

Well No.

Farm

Company

NORTH

WEST

EAST

SOUTH

Location

Drilling Remarks

Rig Up

Drilling Remarks

RECORD

Cased in. ft.

Sand

Gas

Oil

Total Depth

PRODUCTION

1st 24 hrs. Nat.

1st 24 hrs. after shot


Gas cu. ft.

Dry Hole

Abandoned

Map No. **KANSAS** Sec. 19 Twp. 27 R. 10^w
Well No. 1-Miles "North" Farm
Kelly Oil Company

NORTH

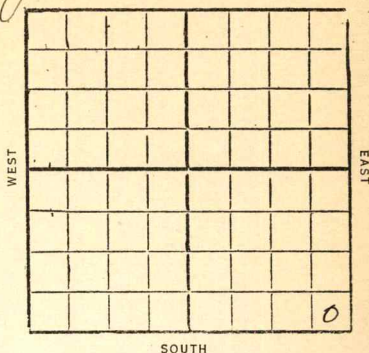

 Ft. from N. Line

330 Ft. from S. Line

330 Ft. from E. Line

 Ft. from W. Line

1932

Date

REPORT

3/30

Loc

4/6

4/13

4/20

4/27

5/4

5/11

5/18

5/25

Prod.
Bedg rotary rig
Cem 12 1/2" - 3270'
Drlg 2115
" 2950'
Top F.C. line 3374
Cem 5" ~~3376 1/4~~ 3371 1/2

6/1

Burst
Cem 5" - 3371 1/2 (54m)
First gas 3390
" Oil 3393
drlg 3437
flow 10 bbl per hr
and 3,400,000 gas
Grav. 36E
(over)

6/8. Cased 5" 3371 1/2
Kansas City line 3374-3496
First gas 3390
" oil 3393
TD 3496
flow 16.5 bbls per day
4 M gas
Comp.

Kingman

54 **KANSAS** Map No. _____ Sec. 19 Twp. 27 R. 10^WWell No. 1 miles " NORTH "
Skelly Oil Co Company

Contractor _____

FIRST REPORTS

_____ Ft. from N. Line

330 Ft. from S. Line330 Ft. from E. Line

_____ Ft. from W. Line

SECTION PLAT

Location ✓

Rig up _____

Drilling and Remarks:

RECORD

Cased _____ in., _____ ft.

Sand _____

Gas _____

Oil _____

Total Depth _____

PRODUCTION

1st 24 hrs. Nat. _____

1st 24 hrs. after shot _____

Gas _____ Cu. Ft.

Dry Hole _____

Abandoned _____

Date

MAR 30 1932

CHAS. L. SHERWOOD

19

Scout

Kingman

w

54 KANSAS

Map No. Sec. 19 Twp. 27 R. 10

Well No. 1 Miles " North "

St Kelly Oil Co

Company

Contractor

COMPLETED

SECTION PLAT

..... Ft. from N. Line

330 Ft. from S. Line

330 Ft. from E. Line

..... Ft. from W. Line

Location

Rig up

Drilling and Remarks:

1st 900 3390

1st 0 3393

Flow 165 Bbl

Per Day

4 A4 Gas

RECORD

Cased 5" in., 3371 1/2 ft.

Sand 3374-3496

Gas

Oil

Total Depth 3496

PRODUCTION

1st 24 hrs. Nat.

1st 24 hrs. after shot

Gas 4 Cu. Ft.

Dry Hole

Abandoned

Date

JUN 8 1932

CHAS. L. SHERWOOD

192

Scout