
Kingman

Form 51—5M—11-31—Palace

Map No. KANSAS Sec. 19 Twp. 27 R. 10 W

Well No. 3 N. Ratcliff Farm

Skelly Oil Company

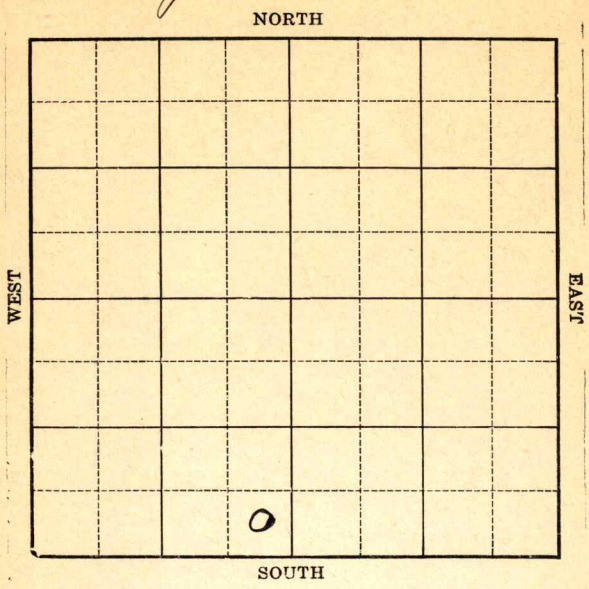

Location

Drilling Remarks

Rig Up

Drilling Remarks

RECORD

Cased ____ in. ____ ft.

Sand

Gas

Oil

Total Depth

PRODUCTION

1st 24 hrs. Nat.

1st 24 hrs. after shot

Gas ____ cu. ft.

Dry Hole

Abandoned


Kingman

Form 252A—5M—11-29—38055

Map No. KANSAS Sec. 19 Twp. 27 R. 10W

Well No. 3 N. Ratcliff Farm

Skelly Oil Company

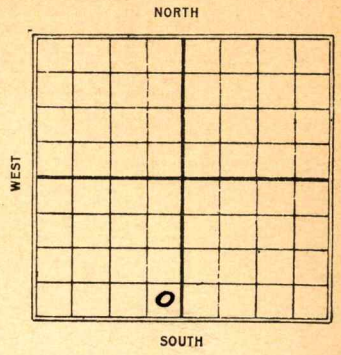

____ Ft. from N. Line

440 Ft. from S. Line

440 Ft. from E. Line

____ Ft. from W. Line

Date 1934	REPORT
4/18	Rot. Rig
4/26	Rigg up
5/3	Dlg 2000
5/10	" 3280 13" 347
5/18	K.C.L. 3417 7" 3417
	TD 3433 Rust
5/25	—
5/31	TD 3470 acidize
6/7	— 6/14 —
6/27	K.C. 3417 TD 3492
	1000 Gal 300 Bbls.

COMPLETED

Form 26—1M Bks.—9-28

KANSAS

Kingman

Map No. 34 Sec. 19 Twp. 27 R. 10 W


Well No. 3- No Ratcliff

Shelly oil Company

Contractor

FIRST REPORT

SECTION PLAT

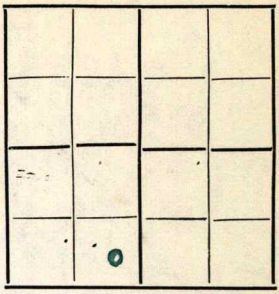

Ft. from N. Line

440 Ft. from S. Line

440 Ft. from E. Line

Ft. from W. Line

Location

Rig up

Drilling and Remarks:

Rot. Rig

RECORD

Cased in., ft.

Sand

Gas

Oil

Total Depth

PRODUCTION

1st 24 hrs. Nat.

1st 24 hrs. after shot

Gas Cu. Ft.

Dry Hole

Abandoned

Date

4-18-34 192

ORVAL MANNSCHRECK Scout

Form 26—1M Bks.—2-29

Kingman KANSAS

Map No. 54 Sec. 19 Twp. 27 R. 10W


Well No. 3- No. Ratcliff

Skelly Oil Company

Contractor

COMPLETED

SECTION PLAT

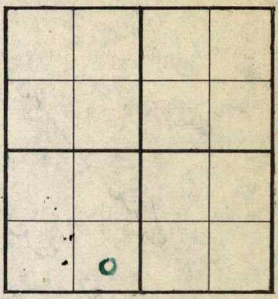

____ Ft. from N. Line

440 Ft. from S. Line

440 Ft. from E. Line

____ Ft. from W. Line

Location ____

Rig up ____

Drilling and Remarks:

1000 Gallon

300 bbls

RECORD

Cased ____ in., ____ ft.

Sand KC 3417

Gas ____

Oil ____

Total Depth 3492

PRODUCTION

1st 24 hrs. Nat. ____

1st 24 hrs. after shot ____

Gas ____ Cu. Ft.

Dry Hole ____

Abandoned ____

ORVAL MANNSCHRECK

Date

6-27-34 19 ____ Scout