


Section 19 Township 27 Range 10-W

Well No. 1 Miles "D"

Company Skelly

Cunningham Gas Pool

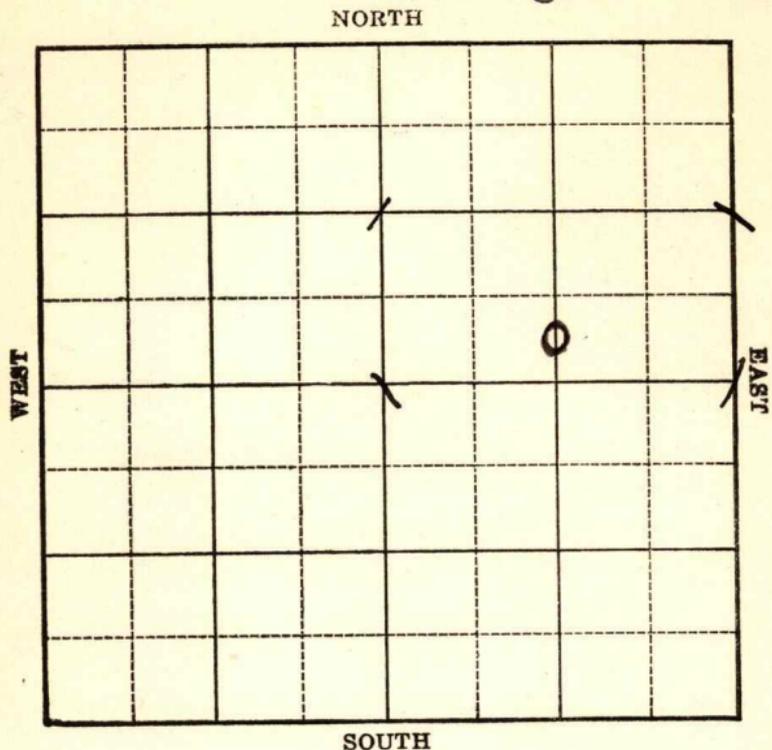

Sec. 19 Twp. 27 R. 10-W

Well No. #1 Miles "D" Farm _____

Skelly Company _____

(Cunningham Gas Pool)


_____ Ft. from N. Line

330 Ft. from S. Line

1320 Ft. from E. Line

_____ Ft. from W. Line

Elev. 1758

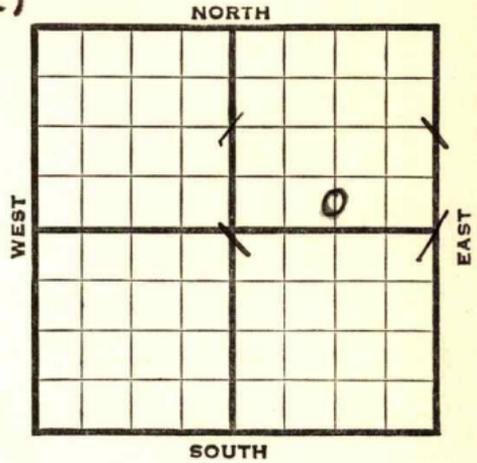

1939	REPORT
2/21	Cellar.
3/3	10" - 387' WOC.
3/10	T. D. 2060' SD repairs.
3/17	Drlg. 3120'
3/24	Lans. 3483-3504' S. O. & G.
	7" - 3490' RUST.
3/31	T. D. 3538' 2 bbls. water in 1
	hour. S. O. Will plug back.
4/5	7" - 3490'
	Lans. 3483'
	T. D. 3538' S. W.
	P. B. to 3500'
	3750 acid.
	Flowed 116 bbls. 8 hours.
	Potential 347 bbls. Show water.
	COMPLETED

Kingman **KANSAS**

Map No. 54 Sec. 19 Twp. 27 R. 10W

Well No. 1 Miles "D"

Skelly Company

Contractor

FIRST REPORT

C S L N E


_____ Ft. from N. Line

330 Ft. from S. Line

1320 Ft. from E. Line

_____ Ft. from W. Line

SECTION PLAT

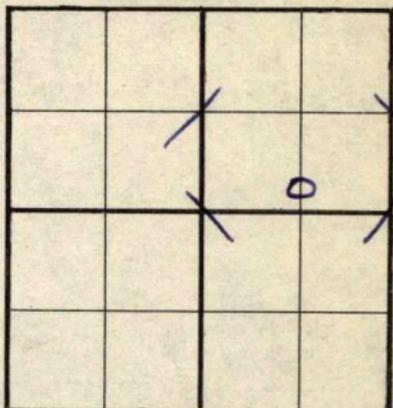

CUNNINGHAM GAS POOL

Location _____

Rig up _____

Drilling and Remarks:

Cellar

RECORD

Cased _____ in., _____ ft.

Sand _____

Gas _____

Oil _____

Total Depth _____

PRODUCTION

1st 24 hrs. Nat. _____

1st 24 hrs. after shot _____

Gas _____ Cu. Ft.

Dry Hole _____

Abandoned _____

Date

FEB 21 1939 19

H. D. Hatfield Scout

