


*Kingman*

Form 51-5M-11-31-Palace

Map No. **KANSAS** Sec. *19* Twp. *27* R. *10<sup>w</sup>*

Well No. *4 N. Miles* Farm \_\_\_\_\_  
*Skelly Oil.* Company \_\_\_\_\_

NORTH

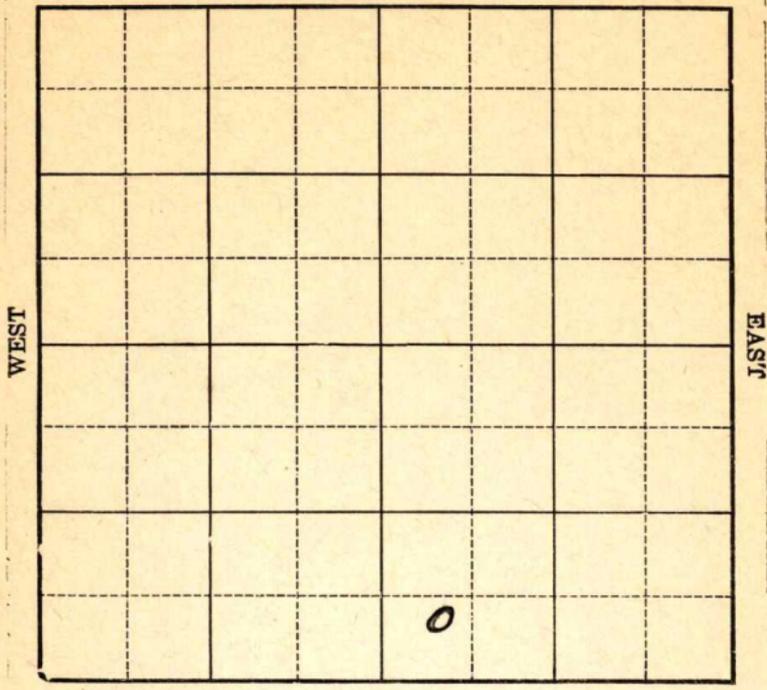

SOUTH

Location \_\_\_\_\_

Drilling Remarks \_\_\_\_\_

\_\_\_\_\_

\_\_\_\_\_

Rig Up \_\_\_\_\_

Drilling Remarks \_\_\_\_\_

\_\_\_\_\_

\_\_\_\_\_

**RECORD**

Cased \_\_\_\_\_ in. \_\_\_\_\_ ft.

Sand \_\_\_\_\_

Gas \_\_\_\_\_

Oil \_\_\_\_\_

Total Depth \_\_\_\_\_

**PRODUCTION**

1st 24 hrs. Nat. \_\_\_\_\_

1st 24 hrs. after shot \_\_\_\_\_

Gas \_\_\_\_\_ cu. ft.

Dry Hole \_\_\_\_\_

Abandoned \_\_\_\_\_

*Kingman*

Map No. **KANSAS** Sec. 19 Twp. 27 R. 10<sup>W</sup>


Well No. 4 70 Miles Farm \_\_\_\_\_  
Skelly oil Company \_\_\_\_\_

\_\_\_\_\_ Ft. from N. Line

440 Ft. from S. Line

\_\_\_\_\_ Ft. from E. Line

440 Ft. from W. Line

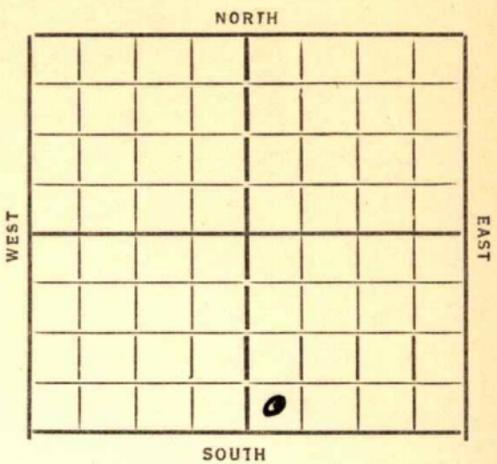

Date 1934

REPORT

6/27	Cellar
7/5	Spuds
7/17	Dly 1805
7/19	" 3080
7/26	Lansing 3423 6" 3417 Rust
8/2	T D 3505 acidizing
8/9	W O F
8/16	Flow 97 Bbls 15 hrs,
8/22	Line 3423 T D 3505
	1000 acid 141 Bbls. 1 gm Gas.

**COMPLETED**

Map No. 54 Sec. 19 Twp. 27 R. 10<sup>w</sup>

Well No. 4 - N. Miles

Spelley oil Company

Contractor

**FIRST REPORTS**

**SECTION PLAT**


\_\_\_\_\_ Ft. from N. Line

440 Ft. from S. Line

\_\_\_\_\_ Ft. from E. Line

440 Ft. from W. Line

Location \_\_\_\_\_

Rig up \_\_\_\_\_

Drilling and Remarks:

*cellar*

**RECORD**

Cased \_\_\_\_\_ in., \_\_\_\_\_ ft.

Sand \_\_\_\_\_

Gas \_\_\_\_\_

Oil \_\_\_\_\_

Total Depth \_\_\_\_\_

**PRODUCTION**

1st 24 hrs. Nat. \_\_\_\_\_

1st 24 hrs. after shot \_\_\_\_\_

Gas \_\_\_\_\_ Cu. Ft.

Dry Hole \_\_\_\_\_

Abandoned \_\_\_\_\_

Date

6-27-34 19

**ORVAL MANNSCHRECK**

Scout

KANSAS

Map No. 54 Sec. 19 Twp. 27 R. 10<sup>W</sup>

Well No. 4-No. Miles

Spelley Oil Company

Contractor

**COMPLETED**

**SECTION PLAT**

		0	

\_\_\_\_\_ Ft. from N. Line

440 Ft. from S. Line

\_\_\_\_\_ Ft. from E. Line

440 Ft. from W. Line

Location \_\_\_\_\_

Rig up \_\_\_\_\_

Drilling and Remarks:

1000 acid

141 bbls

1 m. 920

**RECORD**

Cased \_\_\_\_\_ in., \_\_\_\_\_ ft.

Sand lime 3423

Gas \_\_\_\_\_

Oil \_\_\_\_\_

Total Depth 3505

**PRODUCTION**

1st 24 hrs. Nat. \_\_\_\_\_

1st 24 hrs. after shot \_\_\_\_\_

Gas \_\_\_\_\_ Cu. Ft.

Dry Hole \_\_\_\_\_

Abandoned \_\_\_\_\_

Date

8-22-31

19

**ORVAL MANNSCHRECK**

Scout