


Section 19 Township 27 Range 37W

Well No. #2 Williams

Company Northern Natural

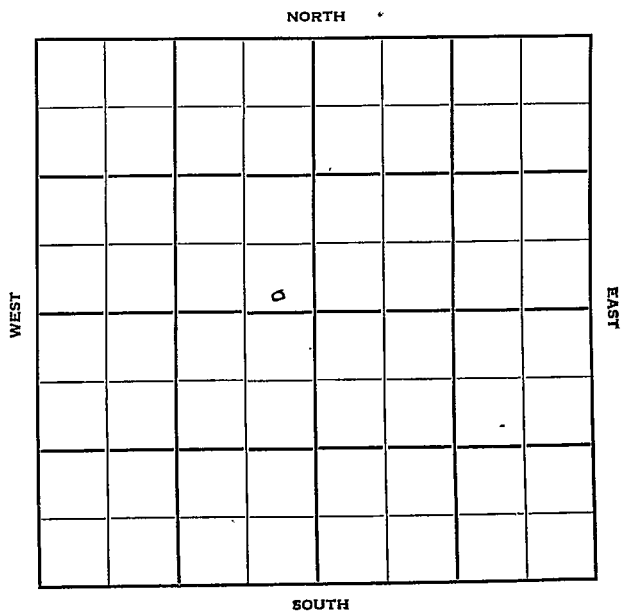

Sec. 19 Twp. 27 R. 37-W

Well No. #2 Williams Farm

Northern Natural Company

Contractor

Hugoton


Ft. from N. Line

200 Ft. from S. Line

300 Ft. from E. Line

Ft. from W. Line

SE NW

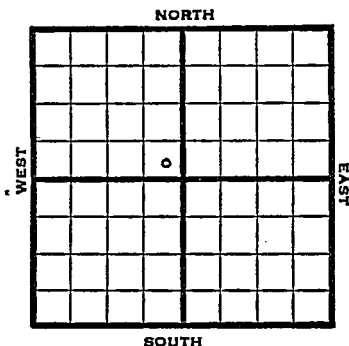

1950

Elev 3079

REPORT

6/7

Location

8/30

10" @ 394

7" @ 2345

TD 2361

Her 2340

Krider 2380

Win 2433

Ft. Riley 2490-2562

TD 2614

Comp. 24,333,000 gas

Completed

**COMPLETED**

Kansas

Map No. \_\_\_\_\_ Sec. 19 Twp. 27 R. 37W

Well No. 2 Williams

Northern Natural Company

Contractor

SE NW

## SECTION PLAT

\_\_\_\_\_ Ft. from N. Line

200 Ft. from S. Line

300 Ft. from E. Line

\_\_\_\_\_ Ft. from W. Line

FIRST REPORT			
	o		

Grant

Location X

Rig up \_\_\_\_\_

Drilling and Remarks:

## RECORD

Cased \_\_\_\_\_ in., \_\_\_\_\_ ft.

Sand \_\_\_\_\_

Gas \_\_\_\_\_

Oil \_\_\_\_\_

Total Depth \_\_\_\_\_

## PRODUCTION

1st 24 hrs. Nat. \_\_\_\_\_

1st 24 hrs. after shot \_\_\_\_\_

Gas \_\_\_\_\_ Cu. Ft.

Dry Hole \_\_\_\_\_

Abandoned \_\_\_\_\_

Date

JUN 7 1950 19

J. E. TYRA Scout

