Pratt


FORM 51

KANSAS

Section 19 Township 27 Range 12W

Well No. #3 Seidel

Company Ross & Schaffer

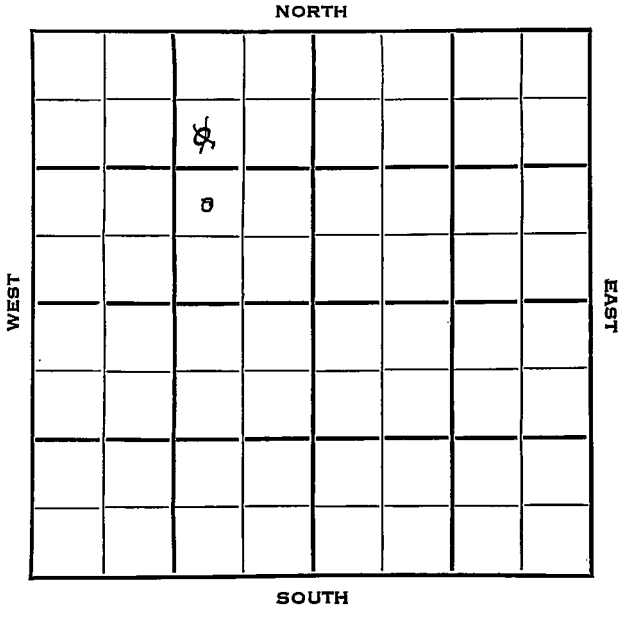

KANSAS

Pratt

SEC.	TWP.	R.
19	27	12W

WELL NO.

#3 Seidel FARM

COMPANY

Ross & Schaffer

CONTRACTOR

Schaffer


S. Iuka-Carmi Pool

~~990~~ Ft. from N. Line

990 Ft. from S. Line

990 Ft. from E. Line

____ Ft. from W. Line

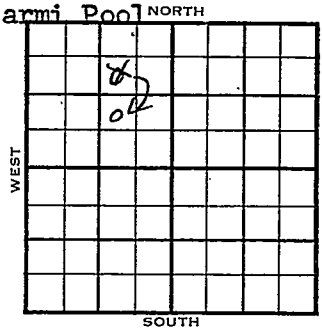

NW SE NW
~~SW NE NW~~

1954	ELEVATION 1873' REPORT
2/3	R U R
2/10	8" @ 350' w/225 sks Anhy 670' DST 3756'-77' 1¼ hr, 60' OCW, 1010# Drlg3792'
2/17	Lans 3725' DST 3751'-72' 1 hr, 6000 gas, 105' ocm 60' ocw 1010# B KC 4063', Cong 4149', Miss 4169' Kh 4188', V 4221', Simp 4263' RTD 4352' 5" @ 4352' Schl.
2/24	C.O. 4327 46/ 4304-19 F 10 BOPH 3 hrs
3/3	Frac F 33 BOPH 5 hrs.
3/10	Spud 1-28-54 Oil Well TD 4352' 8" @ 350' Anhy 670', Heeb 3526', Br. Lime 3703' Lans 3725' DST 3751'-72' opn 1 hr, rec 600' gas,

OVER

DX-78

1954

Information brought forward.

3/10

105' ocm 60' ocw 1010#
B KC 4063', Cong 4149', Miss 4169'
Kh. 4188', Viola 4221', Simp 4263'
TD 4352'
5" @4352'
CO to 4327'
46/ 4304-19 F/ 10 boph 3 hr.
frac.
F/ 33 boph 5 hr.
Comp 2223 bopd.

COMPLETED

FORM 275 FOR SALE BY KANSAS BLUE PRINT CO.


County Pratt State Kansas

Sec. 19 (Blk. Twp.) 27 (Sur. Rge.) 12W Map No.

Operator Ross & Schaffer

Well No. 3 Farm Seidel

Elev. Location SWNE NW

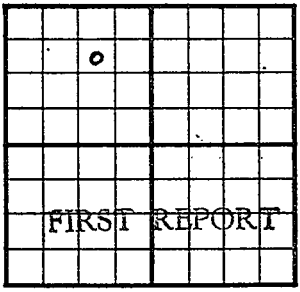

990 Ft. From N Line NW

990 Ft. From E Line Quarter

FEB 3 1954

1st. Report

Completion

Remarks

Schaffer - Contr.


Spudding Date

Drlg. Data S. Inka-Carmi Pool

R U R

J. G. McGEHEE

Drlg. Data

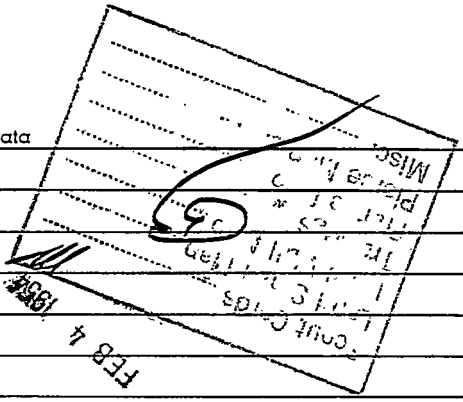

FORM 26 200 BKS. 4-52 PETROL

Kansas

Map No. _____ Sec. 19 Twp. 27 R. 12W


Well No. 3 Seidel

Ross & Schaffer Company

CORRECTION Contractor

NW SE NW

SECTION PLAT

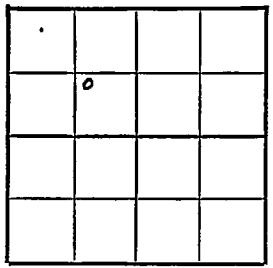

_____ Ft. from N. Line

990 Ft. from S. Line

990 Ft. from E. Line

_____ Ft. from W. Line

Pratt County

Location _____

Rig up _____

Drilling and Remarks:

Reported
SW NE NW

RECORD

Cased _____ in., _____ ft.

Sand _____

Gas _____

Oil _____

Total Depth _____

PRODUCTION

1st 24 hrs. Nat. _____

1st 24 hrs. after shot _____

Gas _____ Cu. Ft.


Dry Hole _____

Abandoned _____

Date

FEB 3 1954 19

T. G. McGEHEE Scout

 

FEB 10 1954

Sewer Cards MM
Land Small Map
Land Wall Map 37
Tracings
Fr nce Map
Photos Map
Misc.

FORM 275 FOR SALE BY KANSAS BLUE PRINT CO.


County Pratt State Kansas

Sec. 19 (Blk. / Twp.) 27 (Sur. / Rge.) 12W Map No.

Operator Ross & Schaffer

Well No. 3 Farm Seidel

Elev. 1873 Location NW SE NW

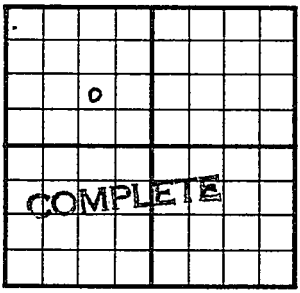

990 Ft. From S Line NW

990 Ft. From E Line Quarter

1st. Report

Completion MAR 1 0 1954

Remarks S. Iuka-Carmi Pool

Schaffer - Contr.

Spudding Date 1-28-54

Drlg. Data Oil well TD 4352

8" @ 350 Anhy 670 Heeb. 3526

Br. lime 3703 Lans. 3725 DST 3751-72

open 1 hr. Rec. 600' gas 105' ocm

60' ocw 1010# B KC 4063 Cong. 4149


Miss. 4169 Kh. 4188 Viola 4221

Simp. 4263 TD 4352 5" @ 4352 CO to 432'

46/ 4304-19 F/ 10 boph 3 hr. frac

F/ 33 boph 5 hr. Comp. 2223 bopd

J. G. McGEHEE

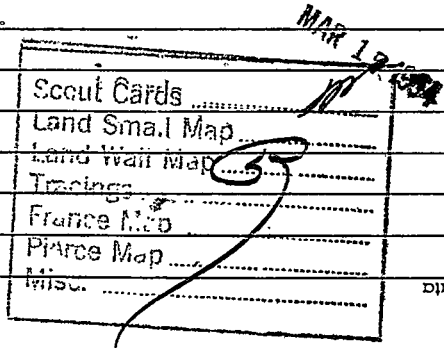
MAR 1
Scout Cards
Land Sma.l Map
Land Wall Map
Tracings
France Map
Pi'ace Map
Misc.
Dtlg. Data