


Section 19- Township 27 Range 12W

Well No. #1 Helmke

Company Stableford et al

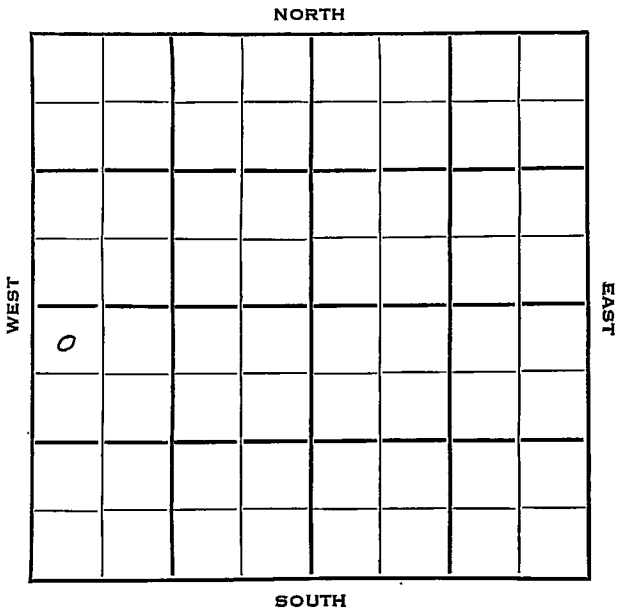



Sec. 19 Twp. 27 R. 12 W

Well No. # 1 Helmke Farm

Stableford et al Company


Shaffer Contractor

330 Ft. from N. Line

_____ Ft. from S. Line

_____ Ft. from E. Line

330 Ft. from W. Line

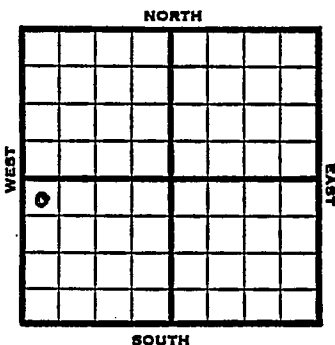

NW NW SW

Stanolind-support

1953

Elev. 1874' REPORT

3/25

Spud 3-22-53
8" @ 350
Drlg. 1800'

4/2

Anhy 663-85, Heeb 3526, Br Li 3710
Lans 3726
Drlg 3827'

4/9

Miss 4171, V 4235

4/15

Spud 3-22-53
D & A
TD 4408'
8" @ 350'
anhy 663, Heeb 3526, Br. Lime 3716,
Lans 3726, Miss. 4171, Viola 4235,
Simp sh 4284, Simp dol. 4298, Simp
sd 4313, Arb 4398
TD 4408'
D & A

ABANDONED


County Pratt State Kansas

Sec. 19 (Blk. Twp.) 27 (Sur. Rge.) 12W Map No.

Operator Stableford etal.

Well No. 1 Farm Helmke

Elev. _____ Location NW NW SW

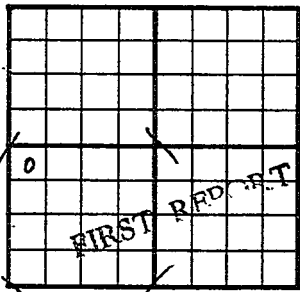

330 Ft. From N Line SW

330 Ft. From W Line Quarter

Ist. Report MAR 25 1953

Completion _____

Remarks Stanolind - support

Shaffer - Contr.

Spudding Date 3-22-53

Drlg. Data _____

8" @ 350 drlg. 1800


County Pratt State Kansas

Sec. 19 (Blk. 27) (Sur. Rge.) 12W Map No.

Operator Stableford et al.

Well No. 1 Farm Helmke

Elev. 1874 Location NW NW SW

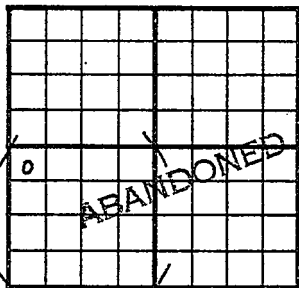

330 Ft. From N Line SW

330 Ft. From W Line Quarter

1st. Report

Completion APR 15 1953

Remarks

Shaffer - Contr. 4

Spudding Date 3-22-53

Drlg. Data D & A TD 4408

8" @ 350 Anhy 663 Heeb. 3526

Br. lime 3716 Lans. 3726 Miss. 4171

Viola 4235 Simp. sh. 4284 Simp. dol. 4298

Simp. sd. 4313 Arb. 4398 TD 4408

D & A