

Section 19 Township 27 Range 12WWell No. 2 Justice "B"Company C R A

0							

NORTH

WEST

EAST

SOUTH

Pratt KANSAS

19

27

12W

Sec. _____ Twp. _____ R. _____

#2 Justice "B"

Well No. _____ Farm _____

C R A

Company _____

C R A

Contractor _____

990

Ft. from N. Line


Ft. from S. Line

Ft. from E. Line

330

Ft. from W. Line

SW NW NW

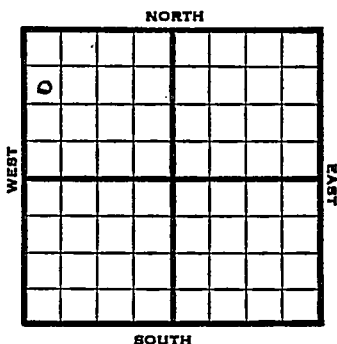

1953

Elev. 1888'

REPORT

4/1

Location

4/9

8" @ 425'
Drlg. 2765'

4/16

Heeb 3539, Br. L. 3715, Lans 3231,
 DST 3760-85 1 Hr. 20 SOCM 28#
 DST 3895-3917 1 Hr. 300' gas 60' Ho&
 gcm
 Drlg 4036'

4/23

Simp 4310'

4/30

RTD 4387
 5" @ 4385'

5/7

CO 4360, 24/4342-50, FU 500' fluid in
 5 mins.,
 S/102 BO + 115 BW 2-1/2 hrs.,
 S/128 BO + 62 BW 4 hrs., sq.

5/21

Testing.

5/28

"

OVER

#2 Justice "B"

1953
6/3

Spud 4-1-53

Oil Well

TD 4387

8" @ 425

Heeb 3536, Br lime 3712, Mans 3730

DST 3760-85, opn 1 hr., rec. 20' socm
28#

DST 3895-3917, opn 1 hr., rec. 350'
gas, 60' ho & gcm, 0#

Simp 4306

TD 4387

5" @ 4385

CO to 4360

24/4342-50, FU 500' fluid in 5 mins.

S/102 bo 115 bw 2½ hrs.

S/128 bo 62 bw 4 hrs.,

CO to 4335, 24/4326-34, S/102 bo
11 bw 11 hrs.

S/16 bo 6 hrs., shut in 8 hrs.

F/35 boph

F/37 bo 1½ h s.,

B KC 4070, Miss 4122, Kh 4146,

Viola 4180, Simp. Sh 4266, Simp

Dol. 4292

Comp. 669 bopd

COMPLETED

J. G. McGEHEE

Scout Cards

Land Small Map

Land Wall Map

Tracings

France Map

Pierce Map

MISC.

APR

6 1953

Orig. Date

County Pratt State Kansas
 Sec. 19 (Blk. Twp.) 27 (Sur. Rge.) 12W Map No.
 Operator C R A
 Well No. 2 Farm Justice "B"
 Elev. 1888 Location SW NW NW

990 Ft. From N Line NW
330 Ft. From W Line Quarter

1st. Report

Completion JUN 3 1953

Remarks

CRA - Contr.

Spudding Date 4-1-53

Drlg. Data Oil well TD 4387
8" @ 425 Heeb. 3536 Br. lime 3712
Lans. 3730 DST 3760-85 open 1 hr.
Rec. 20' socm .28# DST 3895-3917
open 1 hr. Rec. 350' gas 60' ho & gcm
O# Simp. 4300 TD 4387 5" @ 4385
CO to 4360 24/ 4342-50 FU 500' fluid
in 5 min. S/ 102 bo 115 bw 2½ hr.
S/ 128 bo 62 bw 4 hr. CO. to 4335
24/ 4326-34 S/ 102 bo 11 bw 11 hr.
S/ 16 bo 6 hr. shut in 8 hr. F/ 35 boph
F/ 37 bo 1½ hr. B KC 4070 Miss. 4122
Kh. 4146 Viola 4180 Simp. sh. 4266
Simp. dol. 4292 Comp. 669 bopd

J. G. McGEHEE

Scout Cards _____

Land Small Map _____

Land Wall Map 33

Tracings _____

France Map _____

Pierce Map _____

Misc. _____