
FORM 51 25M 3-49 PETROL

Pratt KANSAS

Section 19 Township 27 Range 12 W

Well No. # 2 Sidel

Company Schafer Drlg.

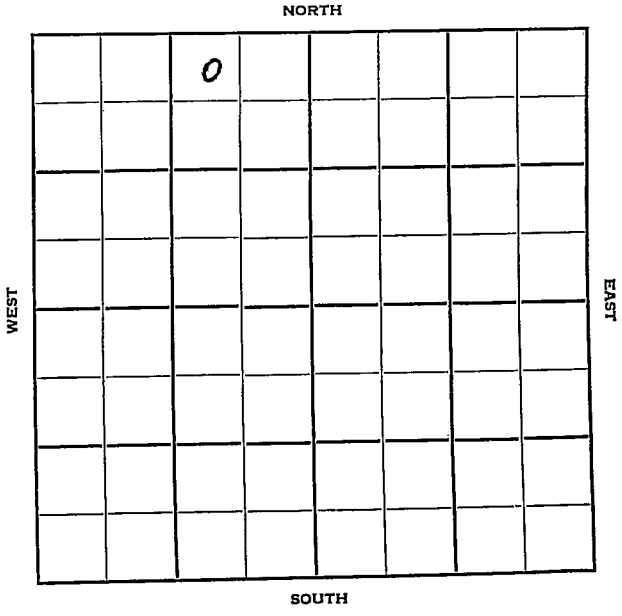

FORM 252-B

Pratt KANSAS ✓

Sec. 19 Twp. - 27 R. 12W

Well No. 2 Sidel Farm

Schafer Drlg. Company

Schafer Drlg. Contractor

S. Iuka Carmi Pool


330 Ft. from N. Line

Ft. from S. Line

990 Ft. from E. Line

Ft. from W. Line

NW NE NW

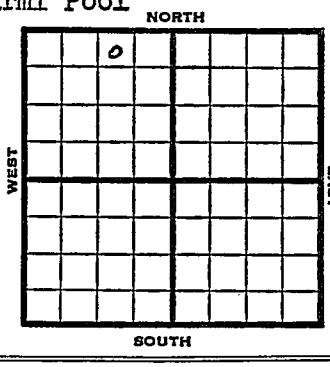

1953	Elev. 1880' REPORT
4/15	Spud 4-9-53 8" @ 347 Anhy 655 Drlg 2673
4/23	Drlg 4334'
4/30	TD 4362' 5" @ 4361'
5/7	NR
5/13	Spud 4-9-53 Oil well TD 4360 8" @ 347 Anhy 655 Heeb 3536 Tor. 3547 Doug. 3568 Lans 3716 B KC 4062 Kh. 4168 Viola 4216 Simp. 4253 TD 4360 5" @ 4360 40/4290-97 97/4302-19 23/4325-33 Comp. 1691 BOPD COMPLETED

FORM 275 FOR SALE BY KANSAS BLUE PRINT CO.


County Pratt State Kansas

Sec. 19 (Blk. Twp.) 27 (Sur. Rge.) 12W Map No.

Operator Schafer Drlg.

Well No. 2 Farm Sidel

Elev. Location NW NE NW

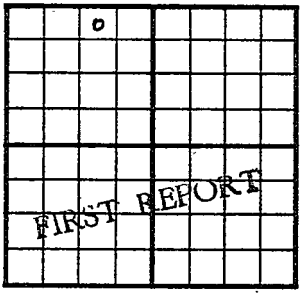

330 Ft. From N Line NW

990 Ft. From E Line Quarter

1st. Report APR 15 1953

Completion

Remarks

Schafer Drlg. - Contr.

Spudding Date 4-9-53

Drlg. Data S. Iuka Carmi Pool

8" @ 347 Anhy 655 drlg. 2673

J. G. McGEHEE

APR 17 1953

Scout Cards
Land Small Map
Land Wall Map
Tracings
France Map
Pierce Map
Misc.

Drlg. Data

FORM 275 FOR SALE BY KANSAS BLUE PRINT CO.


County Pratt State Kansas

Sec. 19 (Blk. Twp.) 27 (Sur. Rge.) 12W Map No.

Operator Schafer Drlg.

Well No. 2 Farm Sidel

Elev. 1880 Location NW NE NW

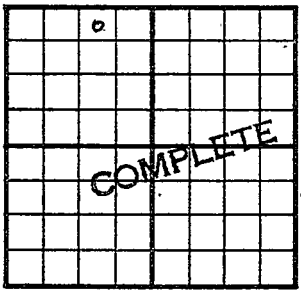

330 Ft. From N Line NW

990 Ft. From E Line Quarter

1st. Report

Completion MAY 1 3 1953

Remarks S. Iuka-Carmi Pool
Schafer Drlg. - Contr.

Spudding Date 4-9-53

Drlg. Data Oil well TD 4360

8" @ 347 Anhy 655 Heeb. 3536

Tor. 3547 Doug. 3568 Lans. 3716

B KC 4062 Kh. 4168 Viola 4216

Simp. 4253 TD 4360 5" @ 4360

40/ 4290-97 97/ 4302-19 23/ 4325-33

Comp. 1691 bopd

J. G. McGEHEE

MAY 19 1953

Scout Cards
Land Small Map
Land Wall Map
Tracings
France Map
Pierce Map
Misc.

Drlg. Data