

Sec. 19 Twp. 27 R. 11-W

Well No. #1 Lehring Farm

Cities Service Oil Gas Company


(Cunningham)

 Ft. from N. Line

990 Ft. from S. Line

 Ft. from E. Line

990 Ft. from W. Line

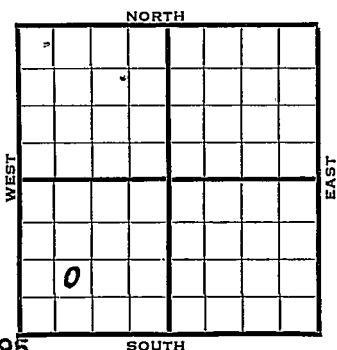

Elev. ~~1797~~ 1795

1940	REPORT
6/26	Derrick.
7/3	10" - 374' Drlg. 595'
7/11	Drlg. 615'
7/18	12" - 197' 8" - 835' WOC.
7/25	Drlg. 3426'
8/2	Drlg. 4129'
8/8	Drlg. 4391'
8/14	5" - 4489 - 4529 T.D.
	R.U.S.T.
8/22	"
8/29	"
9/5	Ft. Riley 1960' Florence 2070'
	Topeka 3100' Lansing 3660'
	Stains 3686-94' Miss. 4107'
	Viola 4317' 4321-41 SSO
	Simp. Shale 4391' Simp. sand
	4402' Arb. 4513' Wtr. 4526-29'
	TD 4529' 4328-74' 48 shots.
	3000 acid. 3500' water.
	OVER

1940

9/11

Arb. 4513'

5" - 4489'

T.D. 4529'

3000 acid.

Water.

ABANDONED

Map No. 54 Sec. 19 Twp. 27 R. 11W

Well No. 1 Lehrling

Cities Service Oil Company

Contractor

FIRST REPORT

SECTION PLAT

NE SW SW

_____ Ft. from N. Line

990 Ft. from S. Line

_____ Ft. from E. Line

990 Ft. from W. Line

CUNNINGHAM POOL

Location _____

Rig up _____

Drilling and Remarks:

Derrick

RECORD

Cased _____ in., _____ ft.

Sand _____

Gas _____

Oil _____

Total Depth _____

PRODUCTION

1st 24 hrs. Nat. _____

1st 24 hrs. after shot _____

Gas _____ Cu. Ft.

Dry Hole _____

Abandoned _____

Date

JUN 26 1940

19

S. I. LEWIS

Scout

Misc. Small Maps	100
Cards	100
Tracing	100
France Map	100
Scarborough Map	100
Moody Map	100
Geological Dept.	100
Moody Flat Book	100

Misc Small Maps	<i>RAM</i>
Cards	<i>RAM</i>
Tracing	<i>JM</i>
France Map	<i>RAM</i>
Scarborough Map	<i>RAM</i>
Moody Map	
Geological Dept.	
Moody Flat Book	

Map No. 54 Sec. 19 Twp. 27 R. 11WWell No. 1 LehrlingCities Service Gas

Company

Contractor

ABANDONED

SECTION PLAT

NE SW SW

_____ Ft. from N. Line

990 Ft. from S. Line

_____ Ft. from E. Line

990 Ft. from W. Line

CUNNINGHAM POOL

Location _____

Rig up _____

Drilling and Remarks:

*Cu & 4513**3" @ 4489**3500 acid**Water*

RECORD

Cased _____ in., _____ ft.

Sand _____

Gas _____

Oil _____

Total Depth 4529

PRODUCTION

1st 24 hrs. Nat. _____

1st 24 hrs. after shot _____

Gas _____ Cu. Ft.

Dry Hole _____

Abandoned _____

Date

SEP 11 1940 19S I LEWIS Scout

Misc Small Maps
Cards
Tracing
Forms
Fish Maps
Dept.
Woody Flat Book