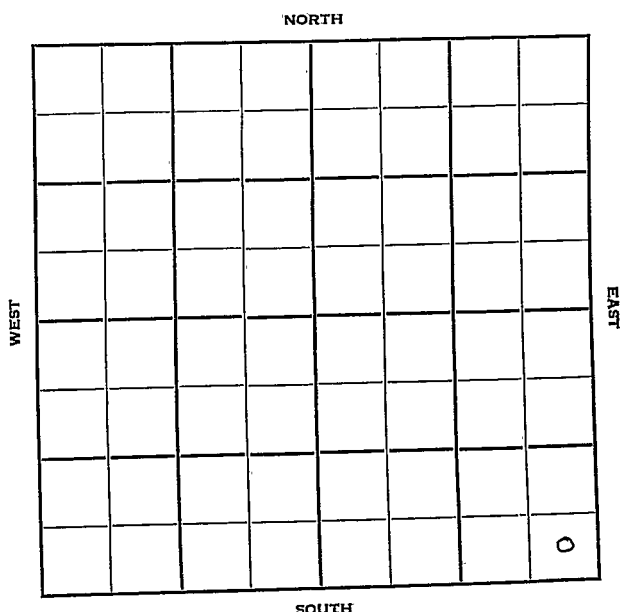


Section 19 Township 27 Range 4-WWell No. #1 SchmidtCompany J. M. Huber etal

Sedgwick **KANSAS**

Sec. 19 Twp. 27 R. 4W

Well No. #1 Schmidt Farm

J. M. Huber et al Company

Contractor


Ft. from N. Line

330' Ft. from S. Line

330' Ft. from E. Line

Ft. from W. Line

SE SE SE

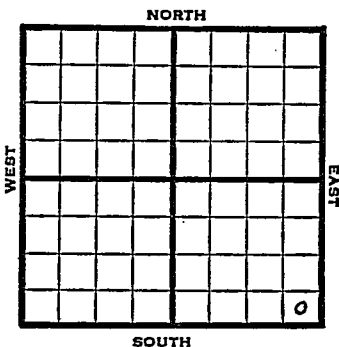

1950

Elev 1430

REPORT

6/14 Spud 6-10-50
8" @ 198'

Drlg. 1420'

6/28 8" @ 198

Br lime 2834

Lans 2863

Miss 3688

DST 3690-3775, op 1 hr rec 60' mud

Viola 4102

Simp sd 4122

TD 4129

D&A

ABANDONED

Kansas

Map No. _____ Sec. 19 Twp. 27 R. 4W

Well No. 1 Schmidt

J. M. Huber et al. Company

Contractor

SE SE SE

SECTION PLAT

_____ Ft. from N. Line

330 _____ Ft. from S. Line

330 _____ Ft. from E. Line

_____ Ft. from W. Line



Sedgwick County

Location _____

Rig up _____

Drilling and Remarks:

Spud 6-10-50

8¹¹ @ 198

drlg. 1420

RECORD

Cased _____ in., _____ ft.

Sand _____

Gas _____

Oil _____

Total Depth _____

PRODUCTION

1st 24 hrs. Nat. _____

1st 24 hrs. after shot _____

Gas _____ Cu. Ft.

Dry Hole _____


Abandoned _____

Date

JUN 14 1950 19

J. E. TYRA

out

 

Scout Cards	✓
Land Small Map	
Land Wall Map	3
Tracings	
France Map	
Pierce Map	
Misc.	

JUN 15 1950

Kansas

Map No. _____ Sec. 19 Twp. 27 R. 4W

Well No. 1 Schmidt

J. M. Huber et al. Company

Contractor

SE SE SE


El. 1430
SECTION PLAT

_____ Ft. from N. Line

330 Ft. from S. Line

330 Ft. from E. Line

_____ Ft. from W. Line

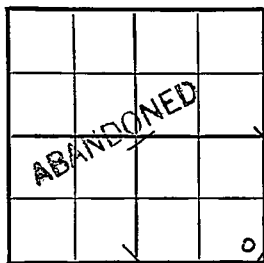

Sedgwick County

Location _____

Rig up _____

Drilling and Remarks:

8" C 198

Br. line 2834

Lans. 2863

Miss. 3688

DST 3690-3775

open 1 hr.

Rec. 60' mud

RECORD

Cased _____ in., _____ ft.

Sand _____

Gas _____

Oil _____

Total Depth 4129

PRODUCTION

1st 24 hrs. Nat. _____

1st 24 hrs. after shot _____

Gas _____ Cu. Ft.

Dry Hole _____

Abandoned _____

Date

JUN 28 1950

19

J. E. TYRA Scout

[illegible][illegible]

3
1950

V 3 E

TD 4129

Stamp. sd. 7122

WFOIA 4102

Scout Cards 7.60
Land Small Map
Land Wall Map
Tracings
France Map
Pierce Map
Misc.