


Section 19 Township 27 Range 4-WWell No. #1 Alexandria (Alexander)Company Pabco Drilg. etal

NORTH

WEST

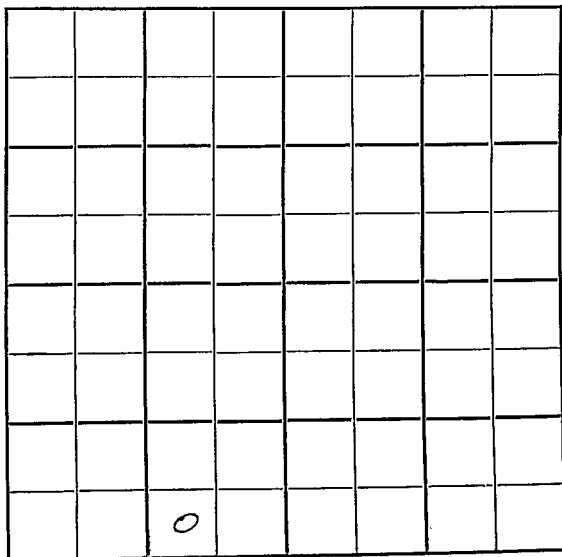

SOUTH

Sedgwick

KANSAS
4W

Sec. 19 Twp. 27 R. 4W

Well No. #1 Alexandria Farm

Pabco Drlg. et al Company

Pabco Drlg. Contractor
Bartholomew Pool

Ft. from N. Line

330'


Ft. from S. Line

990'

Ft. from E. Line

Ft. from W. Line

SW SE SW

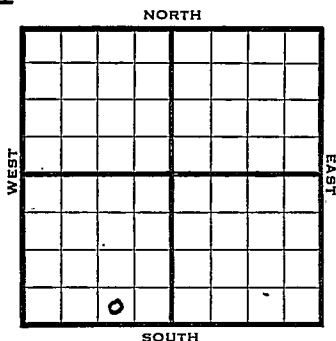

1950

Elev 1462 REPORT

8/23 Location

11/22 Spud 8-23-50

8" @ 174

Lans 2914

Miss 3748

Do1 3780-88

DST 3780-88 opn 1 hr rec 300' oil

30' mud

5" @ 3780


TD 3788

S/104 bo 20 hr

Comp 32 bopd

Completed

COMPLETED

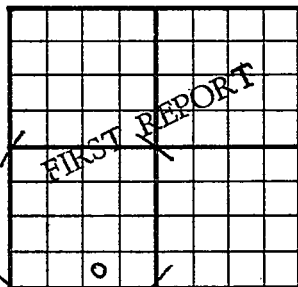County Sedgwick State KansasSec. 19 (Bk.
Twp.) 27 (Sur.
Rge.) 4W Map No.Operator Pabeo Drig. etal.Well No. 1 Farm AlexandriaElev. Location SW SE SW330 Ft. From S Line SW990 Ft. From E Line Quarter1st. Report AUG 23 1950

Completion


Remarks

Spudding Date

Drig. Data Bartholomew PoolLocation

J. E. TYRA

County Sedgwick State Kansas
 Sec. 19 (Blk.) 27 (Sur.) 4W Map No.
 Operator Pabco Drlg. etal.
 Well No. 1 Farm Alexandria
 Elev. 1462 Location SW SE SW

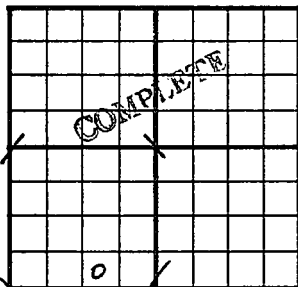

330 Ft. From S Line SW
990 Ft. From E Line Quarter

1st. Report

Completion NOV 22 1950

Remarks Bartholomew Pool

Pabco Drle. - Contr.

Spudding Date 8-23-50

Drig. Data Oil well TD 3788
8" @ 174 Lans. 2914 Miss. 3748

Do1. 3780-88 DST 3780-88 open 1 hr.

Rec. 300' oil 30' mud 5" @ 3780

TD 3788 S/ 104 bo 20 hr.

Comp. 32 bopd

J. E. TYRA