
FORM 51

Sedgwick KANSAS

Section 19 Township 27 Range 4 W

Well No. # 2 Alexander

Company ~~Fraser et al~~ Beardsmore Drlg.

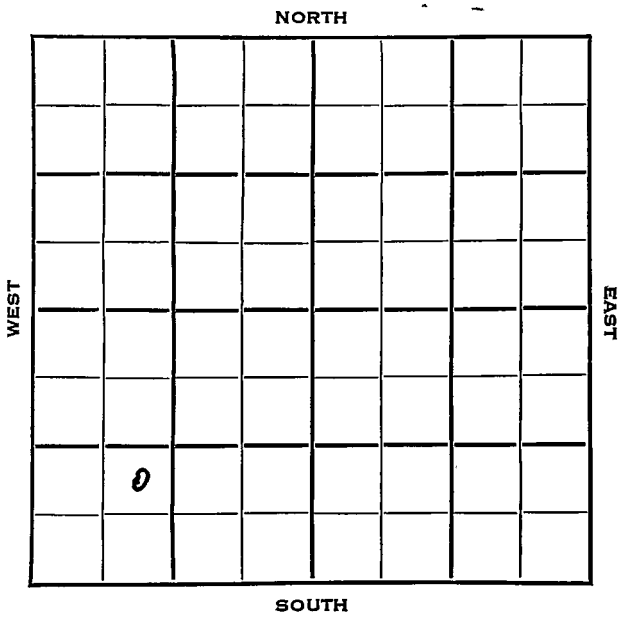

FORM 252-B

Sedgwick KANSAS

Sec. 19 Twp. 27 R. 4W

Well No. #2 Alexander Farm

~~Fraser et al~~ BEARDMORE DRLG Company

Trans-Era Contractor

N. Batholomew Pool


Ft. from N. Line

990 Ft. from S. Line

Ft. from E. Line

990 Ft. from W. Line

NE SW SW

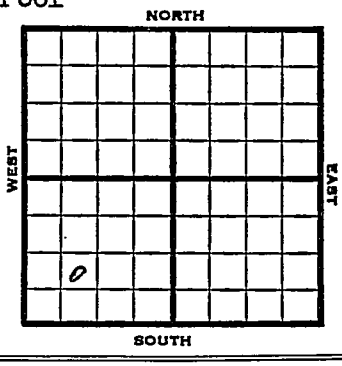


| 1953 | 1465' Elev. REPORT |
|---|---|
| 6/3 | Spud 6-1-53<br>8" @ 192' |
| 6/10 | Drlg. 3065' |
| 6/24 | Br li 2829, Lans 2917, B KC 3372,<br>Miss 3745<br>RTD 3795<br>5" @ 3790<br>WOCT |
| 7/1 | NR |
| 7/8 | " |
| 8/5 | " |
| 8/12 | WOCT |
| 8/19 | " |
| 8/26 | " |
| 9/9 | " |
| 11/18 | Spud 6-1-53 Oil well TD 3795<br>8" @ 192 Br lime 2829 Lans 2917<br>B KC 3372 Miss 3745 TD 3795<br>5" @ 3790<br>DST 3789-95, failed CO to 3795<br>1000 A S/3 BFPH 40% wtr.<br>Comp. 25 BOPD 40% wtr.<br><br>COMPLETED |

FORM 275 FOR SALE BY KANSAS BLUE PRINT CO.


County Sedgwick State

Sec. 19 (Blk. Twp.) 27 (Sur. Rge.) 4W Map No.

Operator Fraser, etal.

Well No. 2 Farm Alexander

Elev. Location NE SW SW

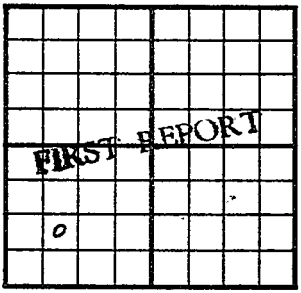


990 Ft. From S Line SW

990 Ft. From W Line Quarter

1st. Report JUN 3 1953

Completion

Remarks

Trans-Era - Contr.

Spudding Date 6-1-53

Drlg. Data N. Bartholomew Pool

8" @ 192

J. G. McGEHEE

FORM 26 200 BKS, 4-52 PETROL

Kansas

Map No. _____ Sec. 19 Twp. 27 R. 4W

Well No. 2 Alexander


Beardmore Drlg. Company

CORRECTION

_____ Contractor

NE SW SW

SECTION PLAT

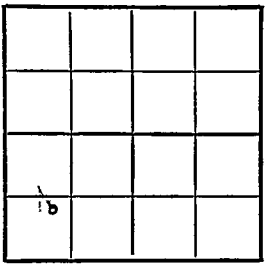

_____ Ft. from N. Line

990 Ft. from S. Line

_____ Ft. from E. Line

990 Ft. from W. Line

Sedgwick County

Location _____

Rig up _____

Drilling and Remarks:

Reported

Fraser etal.

RECORD

Cased _____ in., _____ ft.

Sand _____

Gas _____

Oil _____

Total Depth _____

PRODUCTION

1st 24 hrs. Nat. _____

1st 24 hrs. after shot _____

Gas _____ Cu. Ft.

Dry Hole _____

Abandoned _____

Date

NOV 11 1953 19____

J. G. McGEHEE

_____ Scout

FORM 275 FOR SALE BY KANSAS BLUE PRINT CO.


County Sedgwick State Kansas

Sec. 19 (Blk. Twp.) 27 (Sur. Rge.) 4W Map No.

Operator Beardmore

Well No. 2 Farm Alexander

Elev. 1465 Location NE SW SW

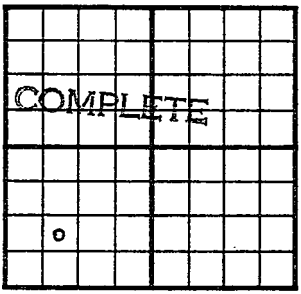


990 Ft. From S Line SW

990 Ft. From W Line Quarter

1st. Report

Completion NOV 18 1953

Remarks N. Bartholomew Pool
Trans-Era - Contr.

Spudding Date 6-1-53

Drlg. Data Oil well TD 3795

8" @ 192 Br. lime 2829 Lans. 2917

B KC 3372 Miss. 3745 TD 3795 5" @ 3790

DST 3789-95 failed CO to 3795 1000 A

S/ 3 bfph 40% wtr.

Comp. 25 bopd 40% wtr.

J. G. McGEHEE