


Section 2 Township 27 Range 7W

Well No. #1 Gorman

Company Morrison Drlg.

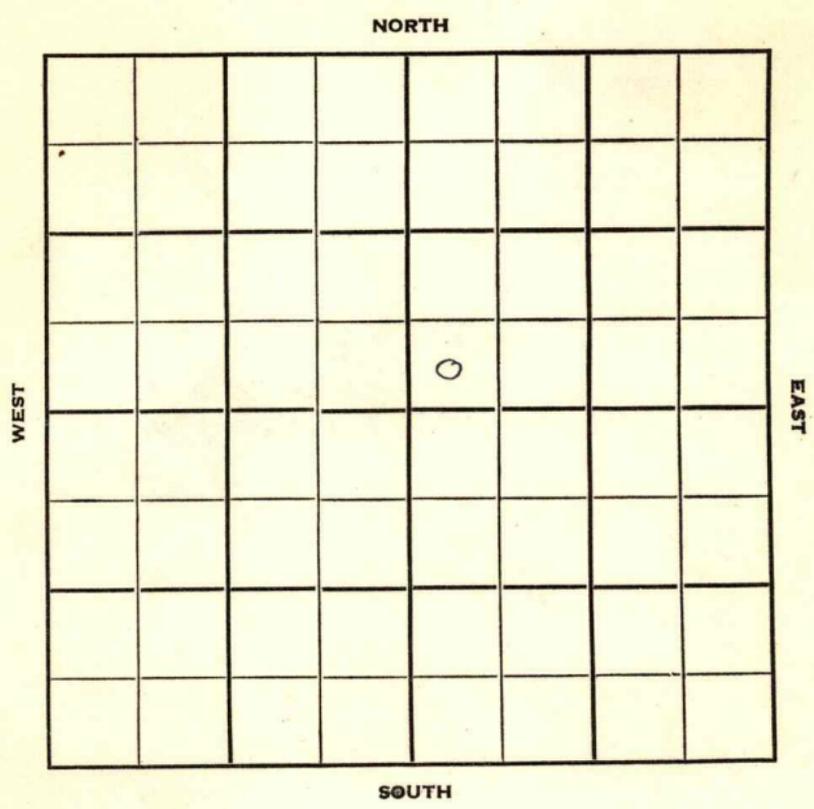

Kingman

KANSAS

Sec. 2 Twp. 27 R. 7W

Well No. #1 Gorman Farm

Morrison Drlg. Company

Wildcat Contractor


 Ft. from N. Line

330' Ft. from S. Line

 Ft. from E. Line

330' Ft. from W. Line

SW SW NE

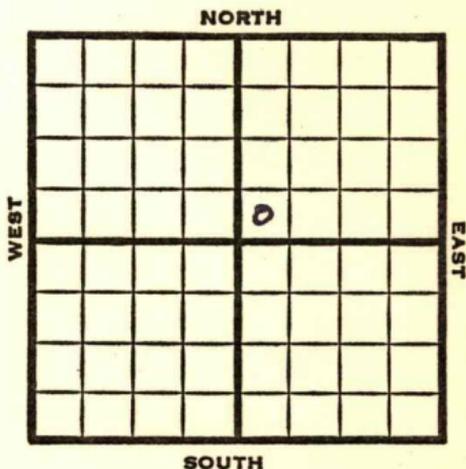

1951 **Elev. 1541'** REPORT

9/19
10/17

Location
 Spud 9-23-51
 D&A TD 4310
 8" @ 290
Top. 2515 Doug. 2530
Br. lm. 3071 Lans. 3096
Miss. 3806
 DST 3808-23 open 45 min. good blow
 gas in 15 min.
 Rec. 200' oil & GCM
 150' O&GCSW 350' SW
Viola 4132
Simp. 4156
Arb. 4255
 TD 4310
 D&A

4310
 4255

 55

ABANDONED

4132
 1541

 2591

4156
 1541

 2615

3806
 1541

 2265

65
 23
 42

Pool Name Wildcat

KANSAS
 Map No. 36 Sec. 10 Twp. 27 R. 7W

Well No. 1 Collingwood

H.K. Porter Co. etal. Company

ABANDONED

Contractor

NW SE

SECTION PLAT

330 Ft. from N. Line

_____ Ft. from S. Line

_____ Ft. from E. Line

330 Ft. from W. Line

		o	

Kingman County

Location _____

Rig up _____

Drilling and Remarks:

*See 44238
 5103940
 Water.*

RECORD

Cased _____ in., _____ ft.

Sand _____

Gas _____

Oil _____

Total Depth 4288

PRODUCTION

1st 24 hrs. Nat. _____

1st 24 hrs. after shot _____

Gas _____ Cu. Ft.

Dry Hole _____

Abandoned _____

Date

MAY 24 1944 19

S. J. LEWIS

Scout

KANSAS

Pool Name Wildcat

Map No. 36 Sec. 10 Twp. 27 R.

Well No. 1 Collingwood

H. K. Porter et al.

CORRECTION

NW SE

SECTION PLAT

330 Ft. from N. Line

_____ Ft. from S. Line

_____ Ft. from E. Line

330 Ft. from W. Line

		o	

Kingman County

Location _____

Rig up _____

Drilling and Remarks:

Reported

W. H. Gaddis
et al.

RECORD

Cased _____ in., _____ ft.

Sand _____

Gas _____

Oil _____

Total Depth _____

PRODUCTION

1st 24 hrs. Nat. _____

1st 24 hrs. after shot _____

Gas _____ Cu. Ft.

Dry Hole _____

Abandoned _____

Date

APR 19 1944 19

S. J. LEWIS Scout

County Kingman State Kansas

Sec. 2 (Blk.) 27 (Sur.) 7W Map No.

Operator Morrison Drlg.

Well No. 1 Farm Gorman

Elev. 1541 Location SW SW NE

BANDONED
0

330 Ft. From S Line NE

335 Ft. From W Line Quarter

Ist. Report

Completion OCT 17 1951

Remarks Wildcat

Spudding Date 9-23-51

Drlg. Data D & A TD 4310

8" @ 290 Top. 2515 Doug. 2530

Br. lime 3071 Lans. 3096 Miss. 3806

DST 3808-23 open 45 min. good blow

gas in 15 min. Rec. 200' oil & gcm

150' o & gcsw 350' sw Viola 4132

Simp. 4156 Arb. 4255 TD 4310

D & A

J. E. TYRA