

DX 78-1

Sedgwick


KANSAS

Section 2 Township 27 Range 1 W

Well No. #6 Ott

Company Drillers Prod. Inc.

NORTH

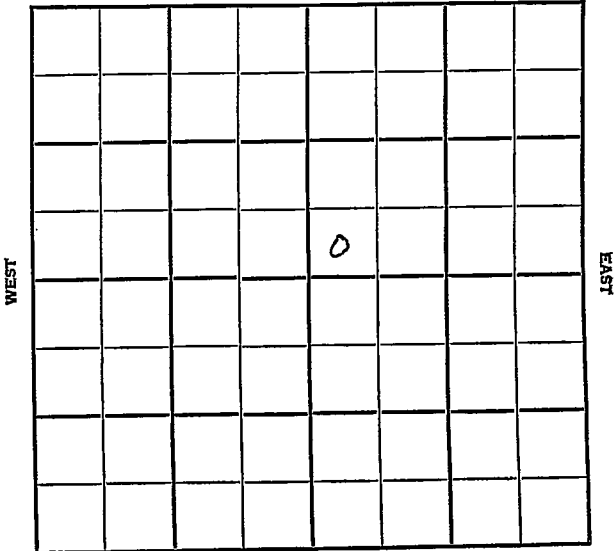

SOUTH

Sedgwick

KANSAS

SEC.	TWP.	R.
2 -	27	1W

WELL NO.

#6 Ott

FARM

COMPANY

Drillers Prod. Inc.

CONTRACTOR

Springer & Harper

Curry

Ft. from N. Line


Ft. from S. Line

Ft. from E. Line

Ft. from W. Line

430

SW SW NE

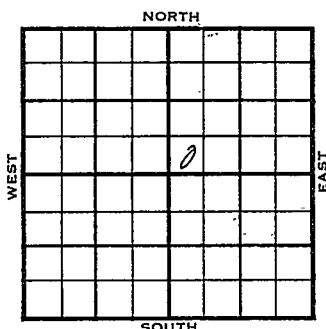

1956

ELEVATION

1321 RB

REPORT

2-29

MIR

3/28

Comm 3-1-56

KC

2582

TD

2692

10 3/4" @ 215/200 7" @ 2692

DD 2702 FU 400' oil 2 hr P/80

15 hr P/59 BO 24 hr Comp 25 bopd

COMPLETED

County **Sedgwick**

Elev.

Sec. **2**

Twp.

27

Rgs.

1WCompany **Drillers Prod. Inc.**

FarmName

Ott

No.

6

TOPS

DEPTH

LOG

DATUM

Loc. in Sec.

Anh.

Tp.

H.

Tr.

Dg.

Bl.

L.

K.C.

B.K.C.

Ce.

C.

M.

M.

K.

Mz.

Mq.

V.

S.

S.

A.

R.

P.E.

G.

T.D.

SW SW NE**430' WL**

Geol.

Contr.

**Springer &
Harper**

Pool

Curry**FEB 29 '56****0****FIRST REPORT**

Date Comm.

M I R

Co.

Use.

No.

Sec.

T.

R.

MAR 7 1956

R. G.

County Sedgewick Elev. 1321 RB
 Sec. 2 Twp. 27 Rge. 1W
 Company Drillers Prod. Inc.
 Farm Name Ott No. 6

TOPS	DEPTH	LOG	DATUM
Anh.			
TP.			
H.			
Tr.			
Dg.			
BL.			
L.			
K.C.	<u>2582</u>		<u>1261</u>
B.K.C.			
Ce.			
C.			
M.			
M.			
K.			
Mz.			
Mq.			
V.			
S.			
S.			
A.			
R.			
PE.			
G.			
T.D.	<u>2692</u>		

Loc. in Sec. SW SW NE130' WLGeol. Springer & HarperContr. PoolCurryMAR 23 '560COMPLETEDate Comm. 3-1-5610 3/4" @ 215/200 7" @ 2692 D^U 2702FU 400' oil 2 hr. P/ 80 bo 15 hr.P/ 59 bo 2 1/2 hr. Comp. 25 bopd

APR 6 1956

M. MC.