

Section 2 Township 27 Range 1 WWell No. # 1 WidnerCompany Drillers Prod.

NORTH

					0		

WEST

EAST

SOUTH

Sedgewick KANSAS

Sec. 2 Twp. 27 R. 1 W. 1

Well No. # 1 Widner Farm

Drillers Prod. Company

Contractor


990 Ft. from N. Line

 Ft. from S. Line

 Ft. from E. Line

990 Ft. from W. Line

SE NW NE

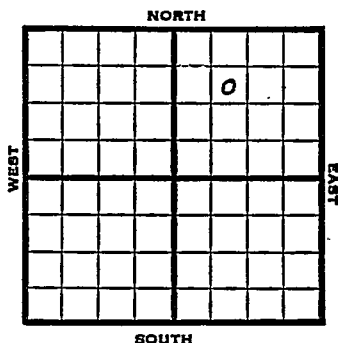


1951 Elev. 1325' REPORT

3/21 Location

5/16 Spud 3-22-51
D&A TD 2727
8" @ 210
KC 2582
DST 2598-2603 opn $\frac{1}{2}$ hr
Rec. 30' mud SO 2699-2712
TD 2727 5" @ 2727
6/2704-06 12/2704-08 S/ $3\frac{1}{2}$ bo 18 bw
16 hr. 750 A S/15 bwph
24/2700-04 wtr 2000 A wtr D&A

ABANDONED

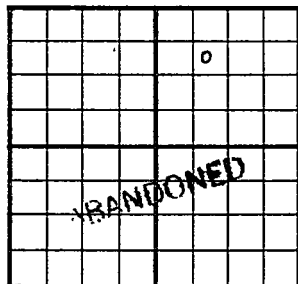County Sedgwick State KansasSec. 2 (Blk.
Twp.) 27 (Sur.
Rge.) 1W Map No.Operator Drillers Prod.Well No. 1 Farm WidnerElev. 1325 Location SE NW NE990 Ft. From N Line NE990 Ft. From W Line Quarter

1st. Report

Completion MAY 16 1951

Remarks

Spudding Date 3-22-51Drlg. Data D & A TD 27278" @ 210 KC 2582 DST 2598-2603open $\frac{1}{2}$ hr. Rec. 30' mud SO 2699-2712TD 2727 5" @ 2727 6/ 2704-0612/ 2704-08 S/ $3\frac{1}{2}$ bo 18 bw 16 hr.750 A S/ 15 bwph 24/ 2700-04 water2000 A water D & A

J. E. TYRA