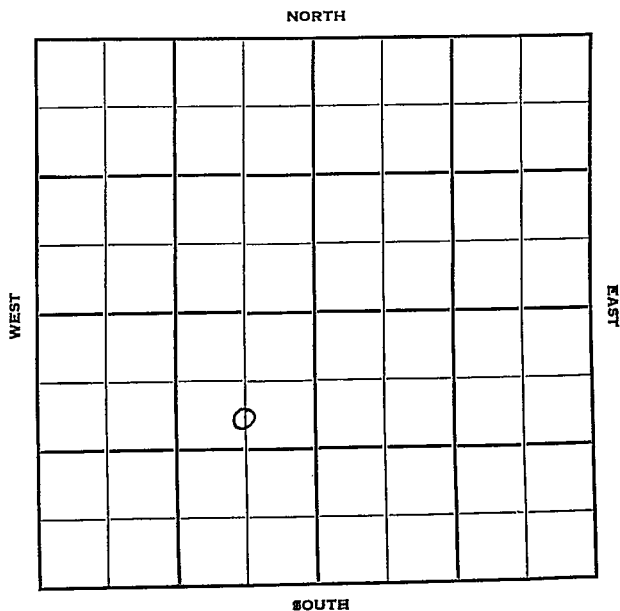


KANSAS

Sedgwick

Section 2 Township 27S Range 1WWell No. #3 CrowleyCompany Drillers Gas.

KANSAS

Sedgwick ✓

Sec. 2 Twp. 27 R. 14

Well No. #3 ~~Growley~~ Southwestern College Farm

Drillers Gas

Company

Cont Harper & Springer

Miscellaneous

990

Ft. from N. Line


Ft. from S. Line

660

Ft. from E. Line

Ft. from W. Line

C S L NE SW

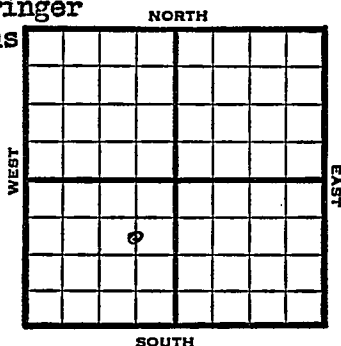

1949

Elev 1327'

REPORT

10/12

8" @ 202'

Drlg 890'

10/19

Drlg 3360'

10/26

KC 2592'

Miss 3076'

Viola 3381'

Simp 3390'

TD 3395'

5" @ 3394'

11/16

TD 3402'

Simp 3390'

5" @ 3394'

Pump 30 Oil Pot

39⁷ Gr.

Comp

COMPLETED

Map No. _____ Sec. 2 Twp. 27 R. 1W

Well No. 3 Crowley

_____ Drillers Gas _____ Company

_____ Harper & Springer _____ Contractor

C S L NE SW

**FIRST REPORT
SECTION PLAT**

990 Ft. from N. Line

_____ Ft. from S. Line

660 Ft. from E. Line

_____ Ft. from W. Line

Sedgwick County

Location _____

Rig up _____

Drilling and Remarks:

8" @ 202

drlg. 890

RECORD

Cased _____ in., _____ ft.

Sand _____

Gas _____

Oil _____

Total Depth _____

PRODUCTION

1st 24 hrs. Nat. _____

1st 24 hrs. after shot _____

Gas _____ Cu. Ft.

Dry Hole _____

Abandoned _____

Date

OCT 12 1949 19

S. J. LEWIS Scout

Kansas

Miscellaneous

Map No. _____ Sec. 2 Twp. 27 R. 1WWell No. 3 Southwestern College

_____ Drillers Gas _____ Company

COMPLETE

Contractor

C S L NE SW


E11327
SECTION PLAT990 Ft. from N. Line

_____ Ft. from S. Line

660 Ft. from E. Line

_____ Ft. from W. Line.

Sedgwick County

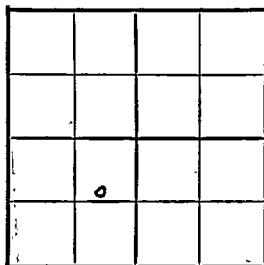

Location _____

Rig up _____

Drilling and Remarks:


RECORD

Cased _____ in., _____ ft.

Sand _____

Gas _____

Oil _____

Total Depth 3402

PRODUCTION

1st 24 hrs. Nat. _____

1st 24 hrs. after shot _____

Gas _____ Cu. Ft.

Dry Hole _____

Abandoned _____

Date

NOV 16 1949

19

S. J. LEWIS Scout