

Map No. KANSAS Sec. 2 Twp. 27 R. 1^w


Well No. 1 - Purry Farm
Plains Oil & Gas Company

_____ Ft. from N. Line

330 Ft. from S. Line

_____ Ft. from E. Line

1155 Ft. from W. Line

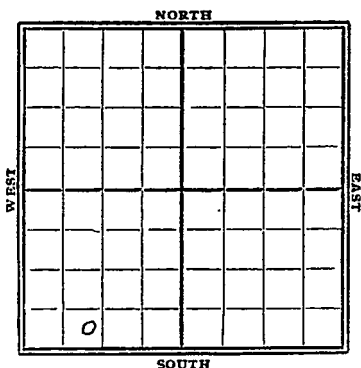

1929

Date	REPORT
7/2	Location
7/10	Pool
7/17	Pool
7/24	Pool
7/31	Pool
8/7	" 275'
8/14	" 1035
8/21	Pool 1700
8/28	Pool 2046
9/4	" 2410
9/11	Pool 2758 K. C. line 2595 10 bbls show 2600-05
9/18	Pool 2955'
9/25	2nd Chok 3077 show oil & water 3089-94 Pool 3100
10/9	Base miss line 3298 Pool 3315'
10/15	2nd Pay 3388 Simpson TD 3389 hole filled with oil 9 bbls near to flowed 20 bbls

10/23- TD. 3389' Strip.
pump 234 bbl oil
and 90 " water
in 24 hrs.

10/29- 131 bbls oil
120 " water

10/30- Pay 3388-3401'
TD. 3401'

170 bbls oil and
100 " water
Don pump
Somp.

Map No. 38 ANASAS Sec. 2 Twp. 27 R. 1W

Well No. 1 Curry

Plains Oil & Gas Company

Contractor

SECTION PLAT

..... Ft. from N. Line

330 Ft. from S. Line

..... Ft. from E. Line

1155 Ft. from W. Line

FIRST REPORTS

Location ✓

Rig up

Drilling and Remarks:

RECORD:

Cased..... in., ft.

Sand.....

Gas.....

Oil.....

Total Depth.....

PRODUCTION

1st 24 hrs. Nat.....

1st 24 hrs. after shot.....

Gas..... Cu. Ft.

Dry Hole.....

Abandoned.....

Date

JUL 2 1928

S. J. LEWIS Scout

no
w...
S...
P

Returned
Cards
Tracing
France Map
Scarborough Map
Moody Map
Scarborough Plat Book
Moody Plat Book

Map No. **KANSAS** Sec. *2* Twp. *27* R. *1W*

38 Well No. *1 Curry*

Plains Oil & Gas Company

Contractor

SECTION PLAT

..... Ft. from N. Line

330 Ft. from S. Line

..... Ft. from E. Line

1165 Ft. from W. Line

COMPLETED

Location.....

Rig up.....

Drilling and Remarks:

Pay 8388-3401
17088 hole &
10088 hole water
pump

RECORD

Cased.....in.,ft.

Sand.....

Gas.....

Oil.....

Total Depth *3401*

PRODUCTION

1st 24 hrs. Nat.....

1st 24 hrs. after shot.....

Gas.....Cu. Ft.

Dry Hole.....

Abandoned.....

Date

OCT 30 1929
192

S. J. LEWIS Scout

no *price* *with*

Returned	<i>278</i>
Cards	<i>278</i>
Tracing	<i>278</i>
France Map	<i>7</i>
Scarborough Map	<i>7</i>
Mecky	<i>7</i>
Starbuck	<i>7</i>
Moody	<i>7</i>