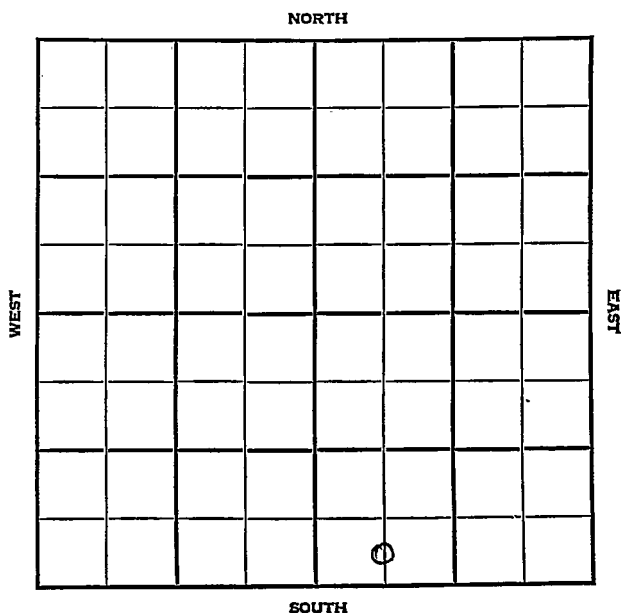


Section 2 Township 27 Range 1WWell No. 1 PritchardCompany Drillers Gas

Sedgwick KANSAS

Sec. 2 Twp. 27 R. 1W

Well No. #1 Pritchard Farm

Drillers Gas Company

Curry


 Ft. from N. Line

330 Ft. from S. Line

 Ft. from E. Line

660 Ft. from W. Line

C S L SW SE

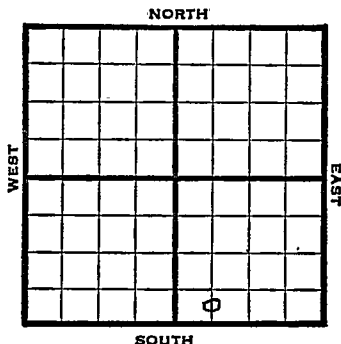

Elev. 1323' REPORT

1947

12/23

Location

1948

1/7

8" @ 175'

Drlg. 1995'

1/14

KC 2599'

Miss 3088'

Simpson 3432'

Arbuckle 3535-50'

TD 3535-50'

5" @ 3535' SWD

1/21

Plug 2735'

12 shots 2631-35 W

1/26

36 shots 2615-39'

SW Squeeze

2/4

53 shots. 3439-49½' SG

2/11

Arb. 3535'

5" @ 3535'

TD 3550'

Abd.

ABANDONED

Map No. _____ Sec. 2 Twp. 27 R. 1W

Well No. 1 Pritchard

_____ Drillers Gas _____ Company

_____ FIRST REPORT _____ Contractor

C S' L SW SE


SECTION PLAT

1 Ft. from N. Line

330 Ft. from S. Line

_____ Ft. from E. Line

660 Ft. from W. Line

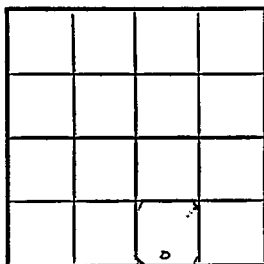

Sedgwick County

Location X

Rig up _____

Drilling and Remarks:

RECORD

Cased _____ in., _____ ft.

Sand _____

Gas _____

Oil _____

Total Depth _____

PRODUCTION

1st 24 hrs. Nat. _____

1st 24 hrs. after shot _____

Gas _____ Cu. Ft.

Dry Hole _____

Abandoned _____

Date

DEC 23 1947

S. J. LEWIS

Scout

Map No. 38 Sec. 2 Twp. 27 R. 1W

Well No. 1 Pritchard

Drillers Gas Company

ABANDONED

Contractor

C S L SW SE

E 1, 1323


SECTION PLAT

 Ft. from N. Line

330 Ft. from S. Line

 Ft. from E. Line

660 Ft. from W. Line

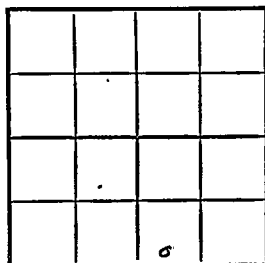

Sedgwick County

Location

Rig up

Drilling and Remarks:

Cur 3535
5 "23035

RECORD

Cased in., ft.

Sand

Gas

Oil

Total Depth 3535

PRODUCTION

1st 24 hrs. Nat.

1st 24 hrs. after shot

Gas Cu. Ft.

Dry Hole

Abandoned

Date

FEB 11 1948 19

S. J. LEWIS Scout