


Section 2 Township 27 Range 1-W

O.W.W.O.

Well No. #3 Ott

Company Drillers Gas

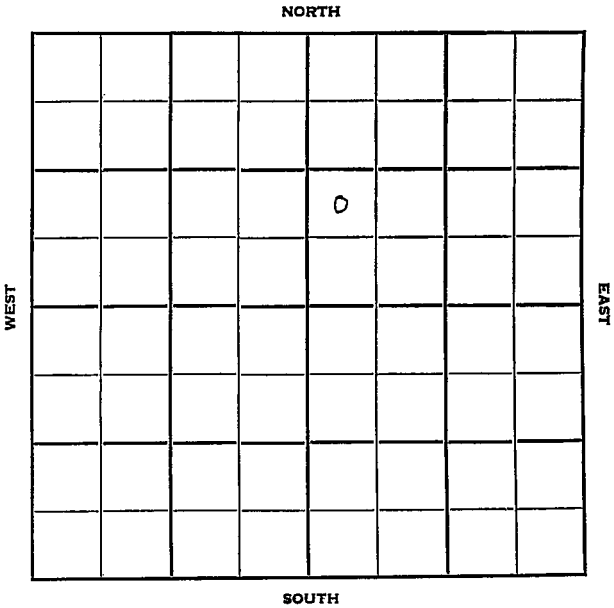

Sec. 2 Twp. 27 R. 1-W

Well No. #3 Ott Farm \_\_\_\_\_

Drillers Gas Company \_\_\_\_\_

Springer-Harper-Contr Contractor \_\_\_\_\_

**O.W.W.O.**


\_\_\_\_\_ Ft. from N. Line

990 Ft. from S. Line

\_\_\_\_\_ Ft. from E. Line

330 Ft. from W. Line

NW SW NE

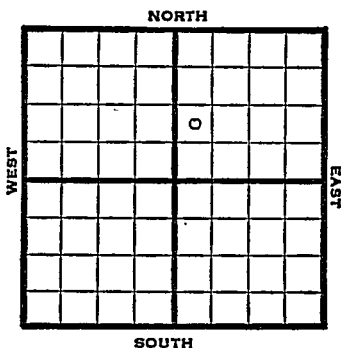

1950 Elev 1325 REPORT

10/11 Spud 10-10-50  
8" @ 215

11/29 Lans 2300 KC 2582  
 Br Lime 2265  
 DST 2598-2603 opn 1/2 hr rec 7' mud  
 DST 2695-2701 opn 1 hr rec 60' ho & gcm  
 & SW  
 Miss 3070  
 DST 3071-77 opn 1 hr rec 30' ocm  
 Simp sd 3400  
 TD 3403  
 5" @ 3400 DD 3409  
 HFW PB 2740  
 24/2694-2700 SO 250A  
 HFW  
 TD 3409  
 D&A

**ABANDONED**

**O.W.W.O.**

1951  
 1/24 KC 2582' Miss 3070' Simp 3400  
 5" @ 3400' OTD 3409  
 was D&A

SP 2740' 16/2694-98 8/2698-2700  
 250 A HFW trace of oil SP 2723  
 500 A HFW Sq. off

**OVER**

1951

2/21 Oil Well TD 2723'  
KC 2582' Miss 3070'  
Simp 3400'  
5" @ 3400 OTD 3409  
SP 2740 16/2694-98  
8/2698-2700 250 A  
HFW SP 2723 500 A  
HFW Perf/2695-2700 500 A  
1 bfph 1500 A Comp. 20 bopd  
80% wtr.

**COMPLETED**

County Sedgwick State Kansas

Sec. 2 (<sup>Blk.</sup>Twp.) 27 (<sup>Sur.</sup>Rge.) 1W Map No.

Operator Drillers Gas

Well No. 3 Farm Ott

Elev. \_\_\_\_\_ Location NW SW NE

		0			

990 Ft. From S Line NE

330 Ft. From W Line Quarter

1st. Report OCT 11 1950

Completion \_\_\_\_\_

Remarks \_\_\_\_\_

Springer - Harper - Contr.

Spudding Date 10-10-50

Drlg. Data

8" @ 215

Scout Cards .....  
Land Small Map .....  
Land Wall Map .....  
Tracings .....  
Fennell Map .....  
Pierce Map .....  
Misc. ....

*700*

OCT 13 1950

Dirg. Data





DEC 6 1950

Scout Cards	700
Land C	
Land W	5
Tr	
Map	
File	
Misc	

Orig. Data



JAN 29 1951

Scout Cards .....  
Land Small Map .....  
Land Wall Map .....  
Tracings .....  
France Map .....  
Pierce Map .....  
MISC. ....

Prig. Data



APR 26 1951

Scout Cards	.....
Land Small Map	.....
Land Wall Map	.....
Tracings	.....
France Map	.....
Pierce Map	.....
Misc.	.....