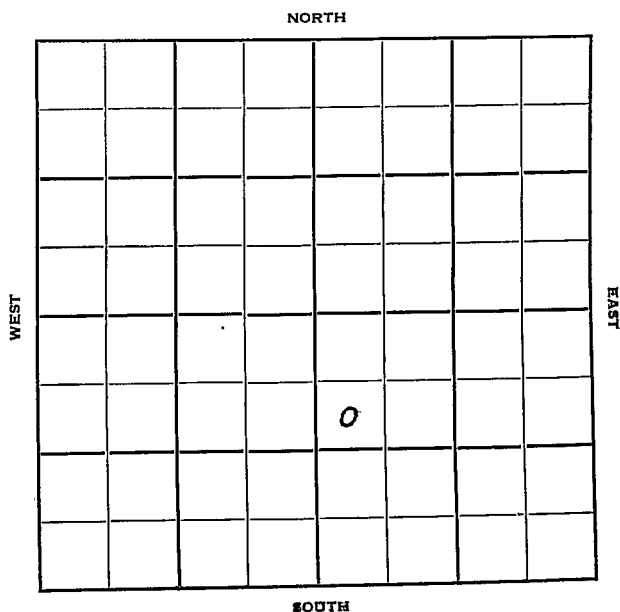


Section 2 Township 27 Range 1WWell No. #5 OttCompany Drillers Prod.

Sedgwick

KANSAS

Sec. 2 Twp. 27 R. 1W

Well No. #5 Ott Farm ☒

Drillers Prod. _____ Company _____

Springer & Harger _____ Contractor _____

Curry Pool

990 Ft. from N. Line


_____ Ft. from S. Line

_____ Ft. from E. Line

330

_____ Ft. from W. Line

SW NW SE

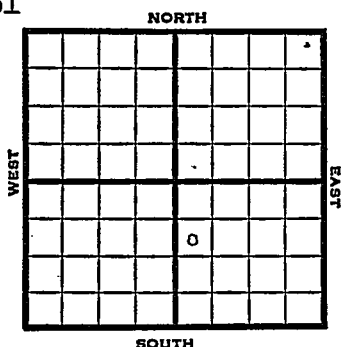

1951

Elev. 1323' REPORT

10/10

Location

1952
1/2

Spud 10-12-51

Oil well TD 2707' 10" @ 205'

KC 2584' 7" @ 2699' TD 2705'

SSO & water 500 A 1 BOPH & tr. wtr

3000 A test all water. DD 2707'


15/2699-2704 water 500 A S/8 BO

13 BW 3 hr. 1000 A

Comp. 20 BOPD

COMPLETED

J. E. TYRA

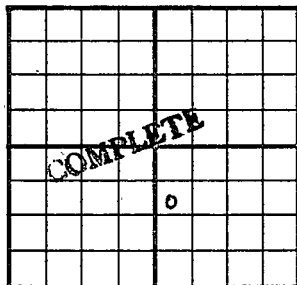County Sedgwick State KansasSec. 2 (Blk. Twp.) 27 (Sur. Rge.) 1W Map No.Operator Drillers Prod.Well No. 5 Farm OttElev. 1323 Location SW NW SE.990 Ft. From N Line SE330 Ft. From W Line Quarter

1st. Report

Completion JAN 2 1952Remarks Curry PoolSpringer & Harper - ContrSpudding Date 10-12-51Drlg. Data Oil well TD 270710" @ 205 KC 2584 7" @ 2699 TD 2705SSO & water 500 A 1 boph & tr. water3000 A test all water DD 270715/ 2699-2704 water 500 A S/ 8 bo13 bw 3 hr. 1000 A Comp. 20 bopd

J. E. TYRA