


Map No. KANSAS Sec. 2 Twp. 27 R. 1^w

Well No. J.C. Peachy Farm
J.C. Johnson Company

NORTH

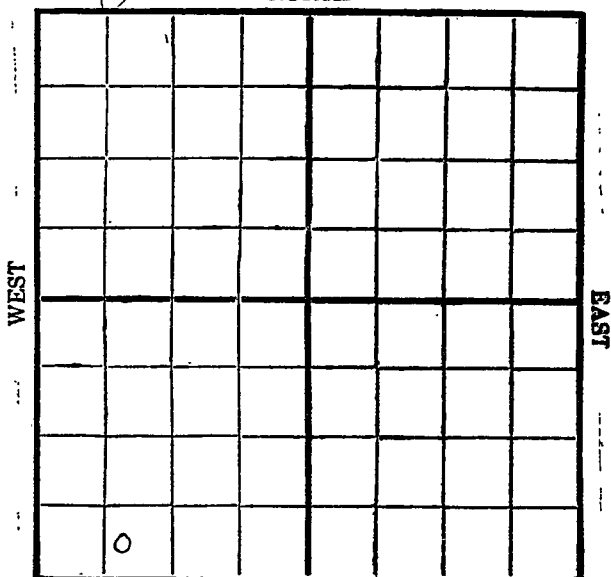

SOUTH

Location _____
Drilling Remarks _____

Rig Up _____
Drilling Remarks _____

RECORD


Cased _____ in. _____ ft.
Sand _____
Gas _____
Oil _____
Total Depth _____

PRODUCTION

1st 24 hrs. Nat. _____
1st 24 hrs. after shot _____
Gas _____ cu. ft. _____
Dry Hole _____
Abandoned _____

Map No. KANSAS Sec. 2 Twp. 27 R. 1^W
 Well No. 1 - Beachy Farm
J.C. Johnson Company

_____ Ft. from N. Line
330 Ft. from S. Line
 _____ Ft. from E. Line
825 Ft. from W. Line

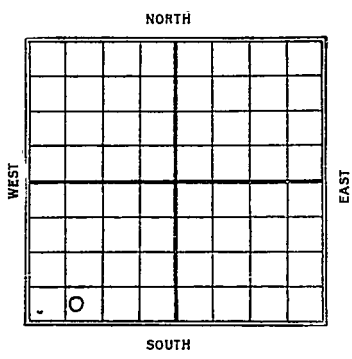

1929

Date	REPORT
10/2	Bldy Rig
10/19	Widn up.
10/16	Shed
10/23	Dry 1410'
10/30	" 2010'
11/6	Top N.C. line 2615' show oil 2727-29 Dry 2745' HFW
11/13	WR. 8" 3065'
11/20	Top chat 3108 show oil at 3110' HFW 3120 WR. 6"
11/27	Wlg 3215'
12/4	Sim 3415 - show oil 3416 HFW 3418 Wlg 3430
12/11	Run 5" - 3467'
12/18	Top shale line 3505' T.D. 3519' HFW Dry & Abandon

Map No. **KANSAS** Sec. *2* Twp. *27* R. *1 W*

Well No. *1 Peckey*

T. C. Johnson Company

Contractor

SECTION PLAT

..... Ft. from N. Line

330 Ft. from S. Line

..... Ft. from E. Line

825 Ft. from W. Line

<i>0</i>			

FIRST REPORTS

Location.....

Rig² up.....

Drilling and Remarks:

Building rig
JD

RECORD

Cased..... in., ft.

Sand.....

Gas.....

Oil.....

Total Depth.....

PRODUCTION

1st 24 hrs. Nat.....

1st 24 hrs. after shot.....

Gas..... Cu. Ft.

Dry Hole.....

Abandoned.....

Date

OCT 2 1929
..... 192.....

S. J. LEWIS Scout

Seeligwick

Map No. **KANSAS** Sec. 2 Twp. 27 R. 1 W.

38

Well No. 1 Peacock

T.C. Johnson Company

Contractor

SECTION PLAT

..... Ft. from N. Line

330 Ft. from S. Line

..... Ft. from E. Line

825 Ft. from W. Line

ABANDONED

Location.....

Rig up.....

Drilling and Remarks:

*Top sil line
3505 NW*

RECORD

Cased..... in., ft.

Sand.....

Gas.....

Oil.....

Total Depth 3519

PRODUCTION

1st 24 hrs. Nat.....

1st 24 hrs. after shot.....

Gas..... Cu. Ft.

Dry Hole.....

Abandoned.....

Date

DEC 18 1929

192.....

S. J. LEWIS Scout