


Section 2 Township 27 Range 1W

Well No. #4 Southwest College

Company Drillers Gas

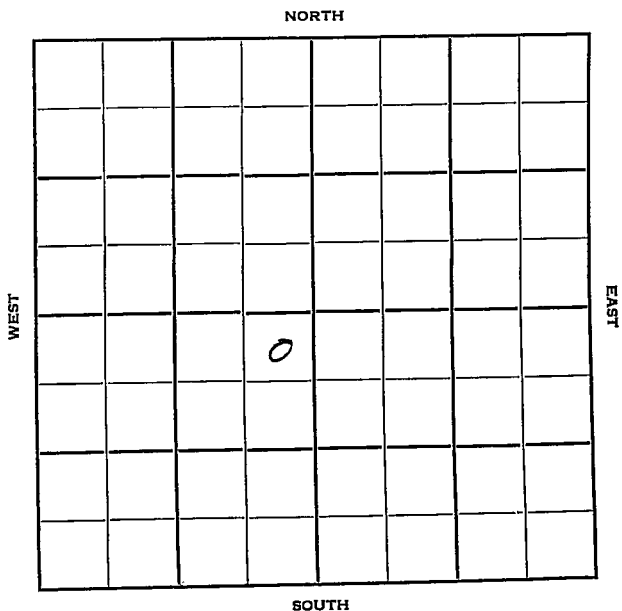

Sedgwick **KANSAS**

Sec. 2 Twp. 27 R. 1W

Well No. #4 Southwest College Farm

Drillers Gas Company


Miscellaneous (Springer, Contr.)
NORTH

330' Ft. from N. Line

_____ Ft. from S. Line

330' Ft. from E. Line

_____ Ft. from W. Line

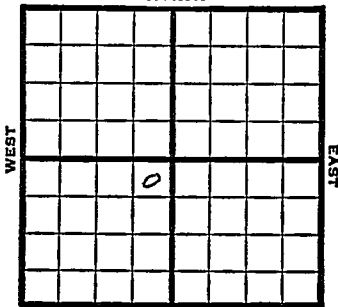

NE SW

SOUTH

1949 Elev 1324' REPORT

12/28 RUR

1950
2/8

TD 3404'
5" @ 3397'
KC 2582'
Viola 3388'
Simp 3393'
P 25 BOPD
Comp

COMPLETED

Kansas

Map No. _____ Sec. 2 Twp. 27 R. 1WWell No. 4 Southwest College

Drillers Gas _____ Company

Springer _____ Contractor

NE SW

FIRST REPORT
SECTION PLAT330 Ft. from N. Line

_____ Ft. from S. Line

330 Ft. from E. Line

_____ Ft. from W. Line

		o	

Sedgwick County

Location _____

Rig up _____

Drilling and Remarks:

R U R

RECORD

Cased _____ in., _____ ft.

Sand _____

Gas _____

Oil _____

Total Depth _____

PRODUCTION

1st 24 hrs. Nat. _____

1st 24 hrs. after shot _____

Gas _____ Cu. Ft.

Dry Hole _____

Abandoned _____

Date

DEC 28 1949 19S. J. LEWIS

Scout

Map No. _____ Sec. 2 Twp. 27 R. 1WWell No. 4 Southwest College_____
Drillers Gas _____ Company_____
Contractor

NE SW

E. 1324

SECTION FLAT

330 Ft. from N. Line

_____ Ft. from S. Line

330 Ft. from E. Line

_____ Ft. from W. Line

	COMPLETE		
	o		

Sedgwick County

Location _____

Rig up _____

Drilling and Remarks:

*5' @ 3397**K.C. 2582**Viola 3388**Simp 3393**P 25 BOPD*

RECORD

Cased _____ in., _____ ft.

Sand _____

Gas _____

Oil _____

Total Depth 3404

PRODUCTION

1st 24 hrs. Nat. _____

1st 24 hrs. after shot _____

Gas _____ Cu. Ft.

Dry Hole _____

Abandoned _____

Date

FEB 8 1950 19J. E. TYRA Scout