


COMPLETION DATA SHEET

L. DRILLING CO., INC.

Lease BISSITT "A"
 Well No. 1 Sec. 29 T. 27S R. 20W
Kiowa Co., Kansas

DIVISION	FIELD FRALICK WEST POOL	LOCATION C SE NE
-----------------	-----------------------------------	----------------------------

WELL PROFILE

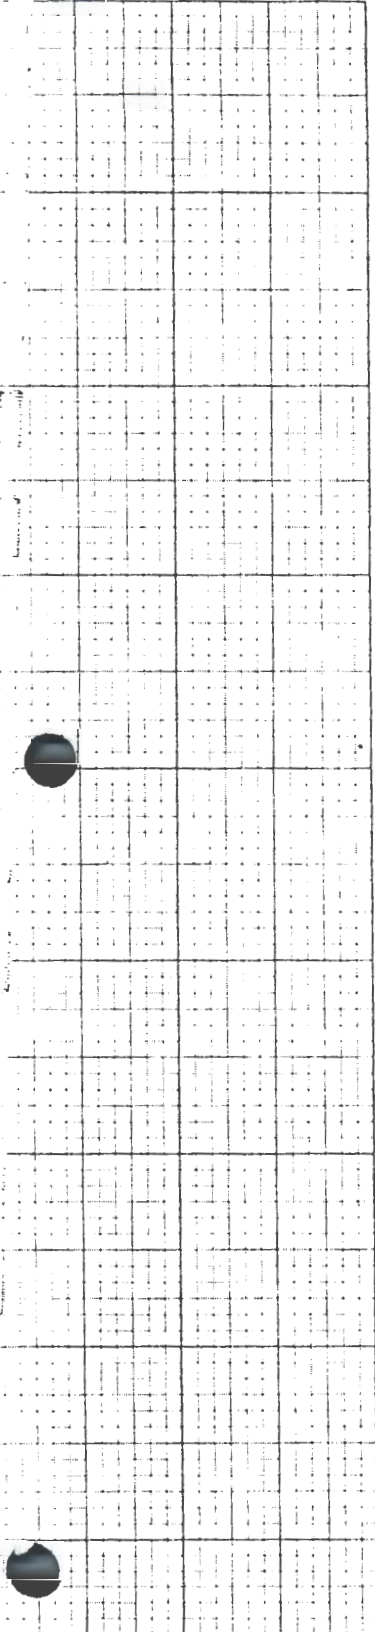

TD	DRILL PIPE	LOG 4917'	ELEVATION	DATUM POINT (GRD-KB-DF) KB
PBTD	DRILL PIPE	GAMMA-RAY 4878'		DATUM POINT ELEVATION 2322'

CASING DESIGN

SIZE	WEIGHT	GRADE	THREAD	COUPLING	MAKE	NO. JTS.	FOOTAGE	BACKS
4 1/2	9.5	J-55	8 RD			157	4914'	125

PERFORATED INTERVAL	FORMATION	REMARKS
4894'-4900'	Mississippi	5/5/65 4 SPF I.P. - 60 BOPD GOR TSTM

COMMENTS:

- 4/16/65 Drilling commenced @ 5:00 a.m.
- 4/26/65 Cored 4881'-4917'
- 5/1/65 Good pay 4894'-4900'. DST #1 4894'-4917'.
Set pipe @ 4914'. Acidized w/250 gal. 200#-900#
- 5/5/65 Perf. 4894'-4900'.
- 5/6/65 Acidized w/250 gal. XW-35.
- 5/8/65 Tank battery completed
- 5/12/65 POP
- 6/17/65 Acidized w/750 gal. of XW-35
- 8/19/65 Acidized w/2500 gal. JEL X-100 retarded acid.

SUBMITTED BY	DATE	APPROVED BY