


Section 20 Township 27 Range 10-W

Well No. 2 Conley

Company Skelly

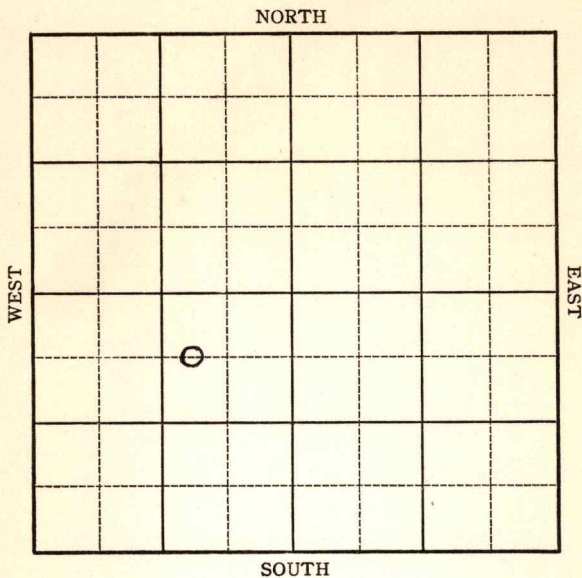

Sec. 20 Twp. 27 R. 10-W


Well No. #2 Conley Farm
Skelly Company

660 Ft. from N. Line

_____ Ft. from S. Line

990 Ft. from E. Line

_____ Ft. from W. Line

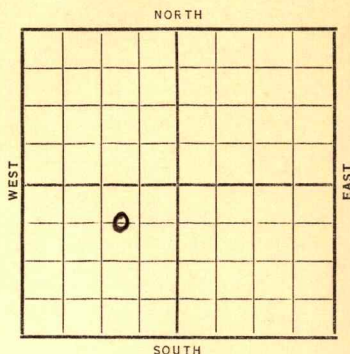

Date	REPORT
1938	
1/12	Mat'l.
1/20	R.U.R.
1/28	12" - 363' Drlg. 840'.
2/4	Drlg. 2250'
2/11	Drlg. 3110'.
2/18	Lans. 3424'. S.O. 3432'.
	Drlg. 3550'.
2/26	Drlg. 3920'.
3/4	Kinderhook 3865-3929'.
-	Viola 3929'. T.D. 3937'.
	S. G. 7" @ 3930'. RUST.
3/9	7" @ 3930'.
	Viola 3926'.
	T.D. 3950'.
	68,688,805 cubic feet of gas.
	COMPLETED

Map No. 54 Sec. 20 Twp. 27 R. 10W

Well No. 2 Conley

Skelly

Company

Contractor

COMPLETED

SECTION PLAT

C W L NE SW

660 Ft. from N. Line

_____ Ft. from S. Line

990 Ft. from E. Line

_____ Ft. from W. Line

	0		

Location _____

Rig up _____

Drilling and Remarks:

*68,688,805
cubic feet gas*

RECORD

Cased 7 in., 3930 ft.

Sand Viola 3926

Gas _____

Oil _____

Total Depth 3950

PRODUCTION

1st 24 hrs. Nat. _____

1st 24 hrs. after shot _____

Gas _____ Cu. Ft.

Dry Hole _____

Abandoned _____

Date

MAR 9 - 1938

19

H. D. Hatfield Scout

Kingman

KANSAS

Map No. 54 Sec. 20 Twp. 27 R. 10W

Well No. 2 Conley

Skelly

Company

Contractor

FIRST REPORT

C W L NE SW

660 Ft. from N. Line

_____ Ft. from S. Line

990 Ft. from E. Line

_____ Ft. from W. Line

SECTION PLAT

	o		

Location _____

Rig up _____

Drilling and Remarks:

Matl

RECORD

Cased _____ in., _____ ft.

Sand _____

Gas _____

Oil _____

Total Depth _____

PRODUCTION

1st 24 hrs. Nat. _____

1st 24 hrs. after shot _____

Gas _____ Cu. Ft.

Dry Hole _____

Abandoned _____

Date

JAN 12 1938 19

H. D. Hatfield Scout