


Section 20 Township 27 Range 10-W

Well No. #3 A. J. Conley

Company Skelly Oil

NORTH Cunningham Pool

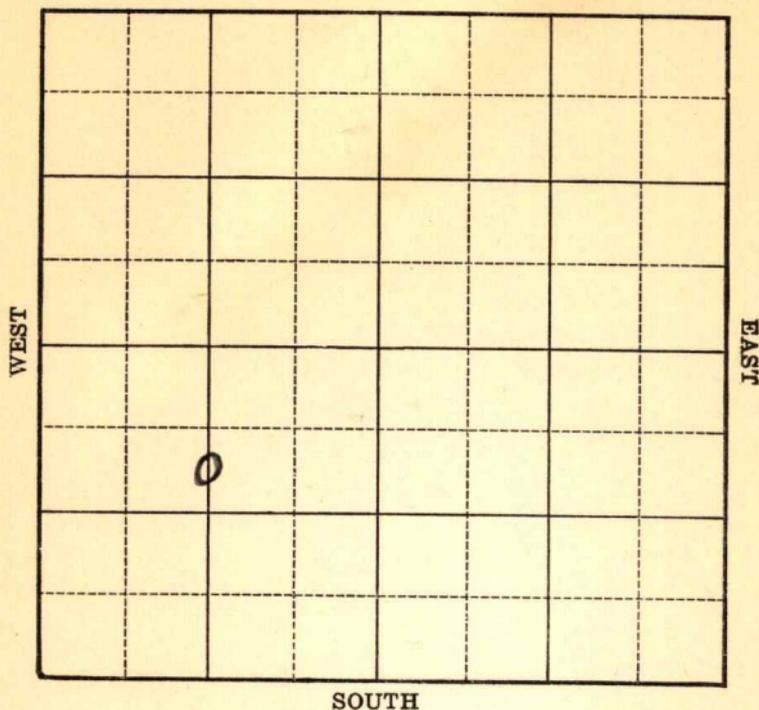

SOUTH

Map No. 54 Sec. 20 Twp. 27 R. 10W

Well No. 3 A. J. Conley

Skelly Oil Company

Contractor

FIRST REPORT

C S L N $\frac{1}{2}$ SW

990 Ft. from N. Line

_____ Ft. from S. Line

_____ Ft. from E. Line

1320 Ft. from W. Line

CUNNINGHAM POOL

SECTION PLAT

	○		

Location _____

Rig up _____

Drilling and Remarks:

Rotary

RECORD

Cased _____ in., _____ ft.

Sand _____

Gas _____

Oil _____

Total Depth _____

PRODUCTION

1st 24 hrs. Nat. _____

1st 24 hrs. after shot _____

Gas _____ Cu. Ft.

Dry Hole _____

Abandoned _____

Date

OCT 4 1939 19

S. J. LEWIS Scout

Map No. 54 Sec. 20 Twp. 27 R. 10W

Well No. 3 A. J. Conley
Skelly Oil Company

Contractor

COMPLETED

SECTION PLAT

C S L N $\frac{1}{2}$ SW

990 Ft. from N. Line

_____ Ft. from S. Line

_____ Ft. from E. Line

1320 Ft. from W. Line

CUNNINGHAM POOL

Location _____

Rig up _____

Drilling and Remarks:

*Leas 3376
8" @ 3381
5000 cu ft
Flow 201 P.D.*

RECORD

Cased _____ in., _____ ft.

Sand _____

Gas _____

Oil _____

Total Depth 3430

PRODUCTION

1st 24 hrs. Nat. _____

1st 24 hrs. after shot _____

Gas _____ Cu. Ft.

Dry Hole _____

Abandoned _____

Date

NOV 8 1939

S. J. LEWIS Scout