


Kingman

Form 51-5M-5-34-Palace

Map No. KANSAS Sec. 20 Twp. 27 R. 10W

Well No. 5 Leisner Farm
Skelly Oil Company

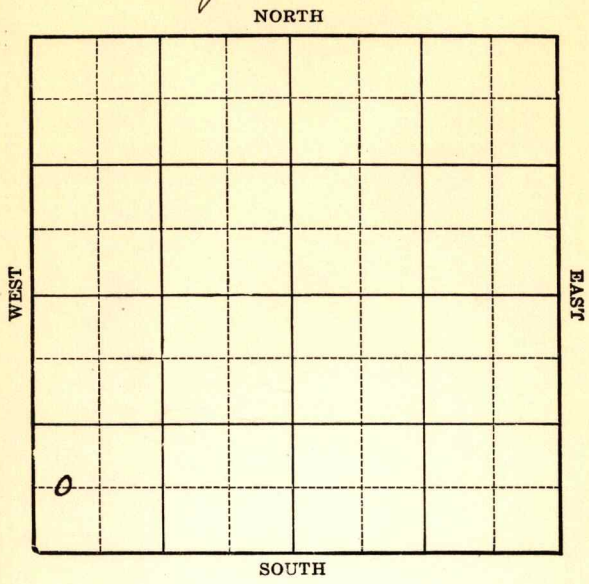

Location _____
Drilling Remarks _____

Rig Up _____
Drilling Remarks _____

RECORD

Cased _____ in. _____ ft.
Sand _____
Gas _____
Oil _____
Total Depth _____


PRODUCTION

1st 24 hrs. Nat. _____
1st 24 hrs. after shot _____
Gas _____ cu. ft.
Dry Hole _____
Abandoned _____

Kingman

Map No. **KANSAS** Sec. 20 Twp. 27 R. 10^W
Well No. 5 Leisman Farm
Shelly Oil Company

Ft. from N. Line
660 Ft. from S. Line
Ft. from E. Line
440 Ft. from W. Line

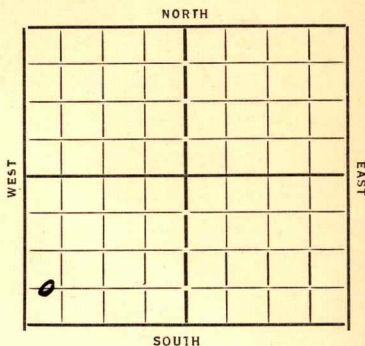

Date 1934

REPORT

10/10 Location
10/18 Rig
10/25 12 1/2 301 WOC
11/1 Dlg 1755
11/8 " 2700
11/15 2875 log drill pipe
11/22
11/28 Dlg 3360
12/6 Lansing 3399 7" 3400
TD 3405 Rust
12/13 Dlg 3462
12/21 1000 acid
12/27 — 1/2/35 —
1/10 Dlg Super
1/17 3489 sho Water PB
1/24 PB 3486 1000 acid
1/31
2/6 Lansing 3399 TD 3489
PB 3486 137 Abbr.

COMPLETED

KANSAS

Map No. 54 Sec. 20 Twp. 27 R. 10WWell No. 5-LeismanSpelley Oil Company

Contractor

FIRST REPORTS

____ Ft. from N. Line

660 Ft. from S. Line

____ Ft. from E. Line

440 Ft. from W. Line

SECTION PLAT

0			

Location ✓

Rig up _____

Drilling and Remarks:

RECORD

Cased _____ in., _____ ft.

Sand _____

Gas _____

Oil _____

Total Depth _____

PRODUCTION

1st 24 hrs. Nat. _____

1st 24 hrs. after shot _____

Gas _____ Cu. Ft.

Dry Hole _____

Abandoned _____

Date

10-10-34 19

ORVAL MANNSCHRECK

Scout

KANSAS

Map No. 54 Sec. 20 Twp. 27 R. 10WWell No. 5-FeismanSpelly oil Company

Contractor

COMPLETED

SECTION PLAT

0			

Ft. from N. Line

660 Ft. from S. Line

Ft. from E. Line

440 Ft. from W. Line

Location

Rig up

Drilling and Remarks:

P.B. 3486137 bbls

RECORD

Cased _____ in., _____ ft.

Sand losing 3399

Gas _____

Oil _____

Total Depth 3489

PRODUCTION

1st 24 hrs. Nat. _____

1st 24 hrs. after shot _____

Gas _____ Cu. Ft.

Dry Hole _____

Abandoned _____

Date

ORVAL MANNSCHRECK

2-6-35 192

Scout