

KANSAS


FORM 51 5M 10-41 PETROL

Kingman

Section 20 Township 27 Range 10-W

Well No. #1 Leisman

Company Skelly

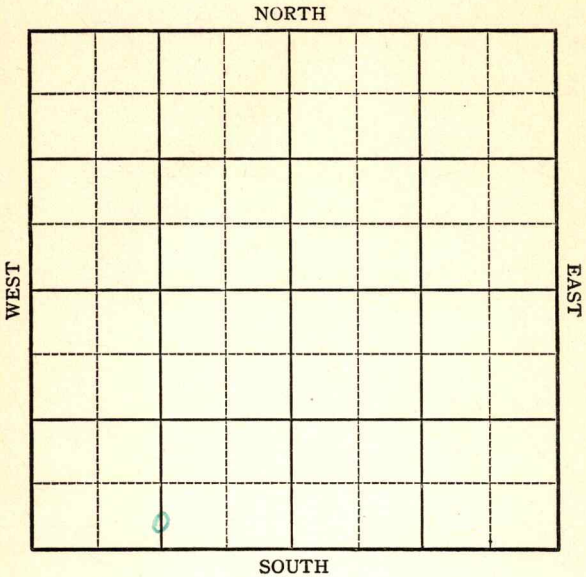

KANSAS


Kingman

Sec. 20 Twp. 27 R. 10-WWell No. #7 Leisman FarmSkelly Company

(Cunningham)

1064 Ft. from N. Line265 Ft. from S. Line Ft. from E. Line1320 Ft. from W. Line

Elev. 1676

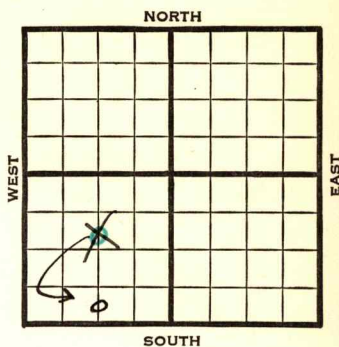

1941	REPORT
11/12	Rotary.
11/20	8" - 363' Drlg. 900'
11/28	Drlg. 2760'
12/4	Drlg. 3947'
12/11	Lans. 3380
	Viola 3095
	Art. 4078
	TD 4221 4" @ 4221 RUST
12/18	72 shots 4778-90 CD
12/24	Squeezed off perforations.
12/31	" " " "
1942	
1/8	12 shots 4159-62½'
	11 " 4162½'-66'
	6 " 4165-67' 16.6 M gas.
	5 water per hour.
1/15	P.B. to 4157' 106 shots 4078
	to 4092' 1500 acid.
	5,198,000 cu. ft. gas.
	OVER

1942

1/21

Arb. 4078'

4" - 4221'

T.D. 4221'

P.B. to 4157'

106 shots 4078-92'

8500 acid.

17,100,000 cu. ft. gas.

COMPLETED


Map No. _____ Sec. 20 Twp. 27 R. 10WWell No. 7 LeismanSkelly CompanyFIRST REPORT ContractorC SL N $\frac{1}{2}$ SW1064 Ft. from N. Line

_____ Ft. from S. Line

_____ Ft. from E. Line

1320 Ft. from W. Line

SECTION PLAT

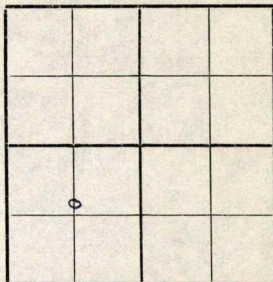

CUNNINGHAM POOL

Location _____

Rig up _____

Drilling and Remarks:

Rotary

RECORD

Cased _____ in., _____ ft.

Sand _____

Gas _____

Oil _____

Total Depth _____

PRODUCTION

1st 24 hrs. Nat. _____

1st 24 hrs. after shot _____

Gas _____ Cu. Ft.

Dry Hole _____

Abandoned _____

Date

NOV 12 1941 19

S. J. LEWIS

Scout

Map No. 54 Sec. 20 Twp. 27 R. 10WWell No. 7 LeismanSkelly CompanyCOMPLETED ContractorC SL S $\frac{1}{2}$ SW


Ft. from N. Line

256 Ft. from S. Line

Ft. from E. Line

1320 Ft. from W. Line

SECTION PLAT

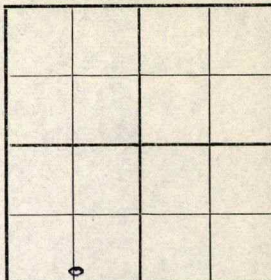

CUNNINGHAM POOL

Location _____

Rig up _____

Drilling and Remarks:

*CR 4078**4" @ 4221**PB 4157**106 shot 4078-92**8500 acid**17,100,000 cu ft*

RECORD

Cased _____ in., _____ ft.

Sand _____

Gas _____

Oil _____

Total Depth 4221

PRODUCTION

1st 24 hrs. Nat. _____

1st 24 hrs. after shot _____

Gas _____ Cu. Ft.

Dry Hole _____

Abandoned _____

Date

JAN 21 1942

19

S. J. LEWIS

Scout

Map No. 11-5-4 Sec. 20 Twp. 27 R. 10WWell No. 7 LeismanSkelly CompanyCORRECTION ContractorC SL S $\frac{1}{2}$ SW Ft. from N. Line256 Ft. from S. Line Ft. from E. Line1320 Ft. from W. Line

SECTION PLAT

CUNNINGHAM POOL

Location Rig up

Drilling and Remarks:

Reported

C SL N $\frac{1}{2}$ SW

RECORD

Cased in., ft.Sand Gas Oil Total Depth

PRODUCTION

1st 24 hrs. Nat. 1st 24 hrs. after shot Gas Cu. Ft.Dry Hole Abandoned

Date

NOV 16 1941 19

S. J. LEWIS Scout