

Kingman


Form 252-A
5M 4-32 MPC

Map No. **KANSAS** Sec. 20 Twp. 27^s R. 10^w

Well No. 1 S. Rouse Farm

Skelly Oil Company

440 Ft. from N. Line
 Ft. from S. Line
1320 Ft. from E. Line
 Ft. from W. Line

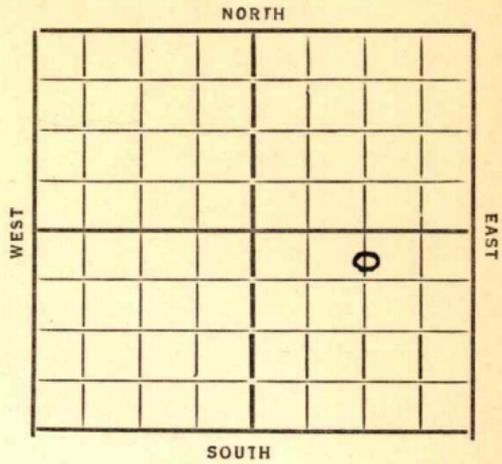

Date 1933

REPORT

10/18 Perd

10/25

11/1 Spudding

11/8 Drly 1680 12" at 344

11/15 " 3225

11/22 " 3486

11/29 Top Line 3493 T.D. 3497

12/6 KC line 3528 - T.D. 3552

 Run 8" at 3535

12/13 R.U.S.T.

12/27 Drly 3678

1/4 " 3807

1/11 " 3910

1/17 6" at 3846 - fish 3973

1/24 T.D. 4004 - UR 6"

1/31 6" 4030 Top Miss 3978

2/7 Drly 4062

2/17 Viola 4282 TD 4283 show oil

2/23 Drly 4345

3/1

3/8 SP 4351

3/15 3/22 3/29 over

1934

4/18 Siliceous 4445 TD 4460
N 7 N D - A

ABANDONED

Kingman
Map No. 34 Sec. 20 Twp. 27 R. 10W

Well No. F. S. Rouse
Skelly Oil Company

Contractor


SECTION PLAT

440 Ft. from N. Line

..... Ft. from S. Line

1320 Ft. from E. Line

..... Ft. from W. Line

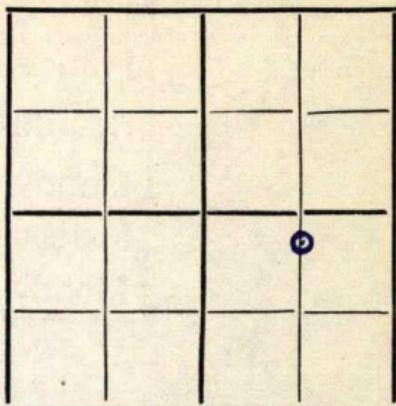

FIRST REPORTS

Location.....

Rig up.....

Drilling and Remarks:

pond

RECORD

Cased..... in., ft.

Sand.....

Gas.....

Oil.....

Total Depth.....

PRODUCTION

1st 24 hrs. Nat.....

1st 24 hrs. after shot.....

Gas..... Cu. Ft.

Dry Hole.....

Abandoned.....

Date

10-18-33 192

O. Manschreck
Scout

Kingman KANSAS

Map No. 54 Sec. 20 Twp. 27 R. 10W

Well No. F. S. Rouse

Shelly oil Company

Contractor

ABANDONED

SECTION PLAT

		0	

440 Ft. from N. Line

_____ Ft. from S. Line

1320 Ft. from E. Line

_____ Ft. from W. Line

Location _____

Rig up _____

Drilling and Remarks:

HFW

10 + A

RECORD

Cased _____ in., _____ ft.

Sand silicious 4445

Gas _____

Oil _____

Total Depth 4460

PRODUCTION

1st 24 hrs. Nat. _____

1st 24 hrs. after shot _____

Gas _____ Cu. Ft.

Dry Hole _____

Abandoned _____

Date

4-18-34 19

ORVAL MANNSCHRECK

Scout