

KANSAS

Grant

FORM 51 25M 3-49 PETROL

Section 20 Township 27 Range 38W

Well No. 1 Wallie "A"

Company Western Natural Gas

Hugoton

NORTH

WEST

EAST

				0					

SOUTH


Sec. 20 Twp. 27 R. 38W

Well No. #1 Wallie-"A" Farm

Western Natural Gas

Hugoton Pool (Livermore, Cont.) Company

NORTH

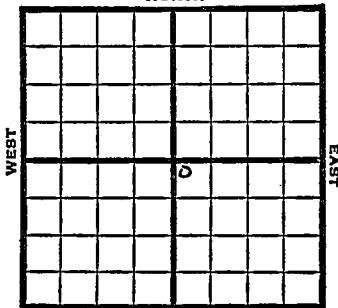

150' Ft. from N. Line

_____ Ft. from S. Line

_____ Ft. from E. Line

150' Ft. from W. Line

NW SE

SOUTH

1949

Elev. 3133' REPORT

8/10

Location

8/16

"

8/24

10" @ 691'

TD 2337 - 7" @ 2336'

8/31

TD 2547'

259' of 5" Perf Liner @ 2547'

9/7

"

9/14

"

9/21

"

10/5

7" @ 2336'

259' of 5" Perf Liner @ 2547'

17000 acid

15 M gas

425# R Pr

TD 2547'

Comp.

COMPLETED

Map No. _____ Sec. 20 Twp. 27 R. 38W

Well No. 1 Wallie "A"

Western Natural Gas Company

Livermoore

Contractor

FIRST REPORT
SECTION PLAT

NW SE

150 Ft. from N. Line

Ft. from S. Line

Ft. from E. Line

150 Ft. from W. Line

		o	

Grant County

Location X

Rig up

Drilling and Remarks:

RECORD

Cased in. ft.

Sand

Gas

Oil

Total Depth

PRODUCTION

1st 24 hrs. Nat.

1st 24 hrs. after shot

Gas Cu. Ft.

Dry Hole

Abandoned

Date

AUG 10 1949 19

S. J. LEWIS Scout

Kansas

Map No. _____ Sec. 20 Twp. 27 R. 38W

Well No. 1 Wallie "A"

Western Natural Gas Company

COMPLETE

Contractor

NW SE

E. J. B. B.

SECTION PLAT

		0	

150 Ft. from N. Line

_____ Ft. from S. Line

_____ Ft. from E. Line

150 Ft. from W. Line

Grant County

Location _____

Rig up _____

Drilling and Remarks:

7" @ 2336
259 2/5" Perf. line
@ 2547
17000 cu. ft.
15 M Gas
H. J. R. B.

RECORD

Cased _____ in., _____ ft.

Sand _____

Gas _____

Oil _____

Total Depth *2547*

PRODUCTION

1st 24 hrs. Nat. _____

1st 24 hrs. after shot _____

Gas _____ Cu. Ft.

Dry Hole _____

Abandoned _____

Date

OCT 5 1949 19

S. J. LEWIS Scout