

Stanton

KANSAS

20

27


40W

SECTION _____ TOWNSHIP _____ RANGE _____

WELL NO. #1 Winger

COMPANY Northern Pump

NORTH C SE

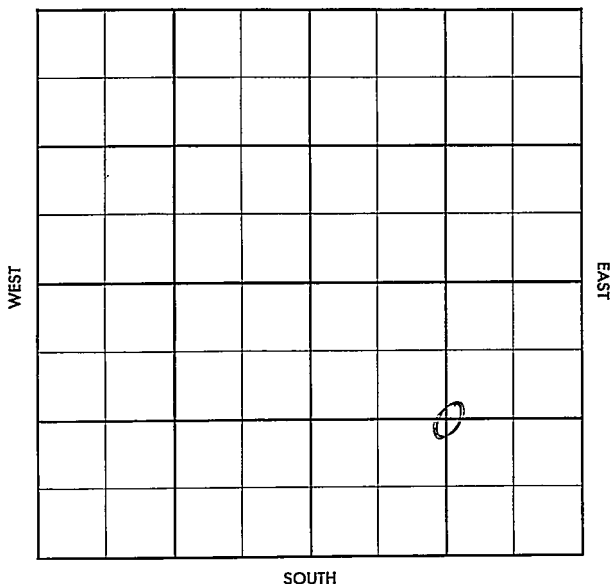

County Stanton Elev. _____
Sec. 20 Twp. 27 Rge. LOW
Company Northern Pump
Farm Name Winger No. 1

TOPS	DEPTH	LOG	DATUM	Loc. in Sec.
Anh.				C SE
TP.				
H.				
Tr.				
Dg.				
BL.				
L.				Geol.
K.C.				Contr.
B.K.C.				Gravey Tools
Ce.				Pool
C.				Hugoton
M.				
M.				
K.				
Mz.				
Mo.				
V.				
S.				
S.				
A.				
R.				
Pe.				
G.				
T.D.				

FIRST REPORT

APR 10 '57

Date Comm. _____
Location _____
34

Co.
L. Sec.
No.
Sec.
T.
R.

County Stanton Elev. 3270
 Sec. 20 Twp. 27 Rge. 40W
 Company Northern Pump
 Farm Name Winger No. 1

TOPS	DEPTH	LOG	DATUM	Loc. in Sec.
Anh. <u>Herr</u>		<u>2222</u>		C SE
Tp. <u>Kri</u>		<u>2238</u>		
H. <u>WEd</u>		<u>2256</u>		
Tr.				
Dg.				
Bl.				
L.				Geol.
K.C.				
B.K.C.				Contr.
Ce.				Gravey Tools
C.				
M.				Pool
M.				
K.				Hugoton
Mz.				
Ma.				
V.				COMPLETE AUG 14 '57
S.				
S.				
A.				
R.				
Pe.				
G.				
T.D.	<u>2300</u>			

Date Comm.

Location APR 17 '57 4-13-57 15" @
390' 325' 22.3' APR 24 '57 7"
@ 2299/600 MAY 1 '57 MAY 13 '57 MAY 15 '57
MAY 22 '57 MAY 23 '57 JUN 5 '57 CO to B.K. 56
JUN 12 '57 CO 2291 25/2270-76
25/2280-86 556 1/2 ga. 7.50 MFL
FR2C 2x1 ga. 2 Mill CFL PB
2264 66/2222-44 FR2C 10x6
ga. 1,800 MFL ga. 2,150 MFL
CO 2291 JUN 19 '57

ga 2,500 MCFG + 5 SW JUN 26 '57
 54d 2222-44 CO 2237
 30/2225-35 IN ga 67 MCFG
 in 12 hrs. JUL 3 '57 F12C ga
 421 MCFG JUL 10 '57 ga 500 MCF
 + 35 Gwph for 5 hrs. JUL 17 '57
 ga 559 MCFG + 20 Gwph
 8 hrs. JUL 24 '57 JUL 31 '57 AUG 8 '57 MICT
 CO 2276 24/2270-76 no inc
 1 1/2 ga 1,118 MCFG / 24 hrs FCP
 300# All 2ms ga. 1,900 MCFG
 Thru C59 / 2 1/2 hrs 72-20
 ga 3,850 MCFG pd. JUL 15 '57
 72-20 4 M, 11 CFC RP 340#