


Section 20 Township 27 Range 39W

Well No. #1 M. Neff

Company Stanolind

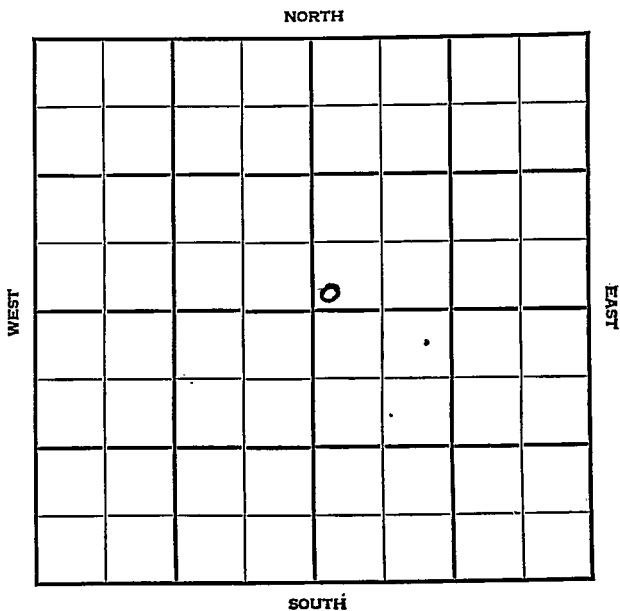



Sec. 20 Twp. 27 R. 39W

Well No. #1 M. Neff Farm

Stanolind Company

Hugoton Pool


\_\_\_\_\_ Ft. from N. Line

150' Ft. from S. Line

\_\_\_\_\_ Ft. from E. Line

150' Ft. from W. Line

SW NE

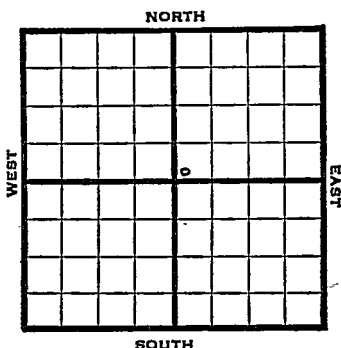

1948

Elev. 3192' REPORT

5/19

Location

5/26

10" @ 646'  
TD 2300'  
7" @ 2281'  
RUST

6/1

TD 2300'

6/9

"

6/16

"

6/23

TD 2490'  
229' of 5" perf liner @ 2490'

6/30

7" @ 2251'  
229' of 4" liner @ 2490'  
16,000 acid  
7,145,000 gas  
R. Pr. 435#  
TD 2490'

COMPLETED

Map No. \_\_\_\_\_ Sec. 20 Twp. 27 R. 39W

Well No. 1 M. Neff

Stanolind Company

FIRST REPORT Contractor

SW NE

SECTION PLAT

\_\_\_\_\_ Ft. from N. Line

150 Ft. from S. Line

\_\_\_\_\_ Ft. from E. Line

150 Ft. from W. Line


Stanton County

Location X

Rig up \_\_\_\_\_

Drilling and Remarks:

RECORD

Cased \_\_\_\_\_ in., \_\_\_\_\_ ft.

Sand \_\_\_\_\_

Gas \_\_\_\_\_

Oil \_\_\_\_\_

Total Depth \_\_\_\_\_

PRODUCTION

1st 24 hrs. Nat. \_\_\_\_\_

1st 24 hrs. after shot \_\_\_\_\_

Gas \_\_\_\_\_ Cu. Ft.

Dry Hole \_\_\_\_\_

Abandoned \_\_\_\_\_

Date

MAY 19 1948

19

S. J. LEWIS

Scout

Map No. \_\_\_\_\_ Sec. 20 Twp. 27 R. 39W

Well No. 1 M. Neff

Stanolind Company

**COMPLETE**

Contractor

SW NE

213192  
 SECTION PLAT

\_\_\_\_\_ Ft. from N. Line

150 Ft. from S. Line

\_\_\_\_\_ Ft. from E. Line

150 Ft. from W. Line

		•	

Stanton County

Location \_\_\_\_\_

Rig up \_\_\_\_\_

Drilling and Remarks:

*7" @ 2281*  
*229' of 4" liner*  
*@ 2490*  
*16000 Cu. ft.*  
*7,145,000 Gal.*  
*435 RE 1/2*

RECORD

Cased \_\_\_\_\_ in. \_\_\_\_\_ ft.

Sand \_\_\_\_\_

Gas \_\_\_\_\_

Oil \_\_\_\_\_

Total Depth 2490

PRODUCTION

1st 24 hrs. Nat. \_\_\_\_\_

1st 24 hrs. after shot \_\_\_\_\_

Gas \_\_\_\_\_ Cu. Ft.

Dry Hole \_\_\_\_\_

Abandoned \_\_\_\_\_

Date

JUN 30 1948

19

S. J. LEWIS

Scout