


SECTION 20 TOWNSHIP 27 RANGE 7W

WELL NO. #1 Wallace

COMPANY Tennessee Gas & Transmission

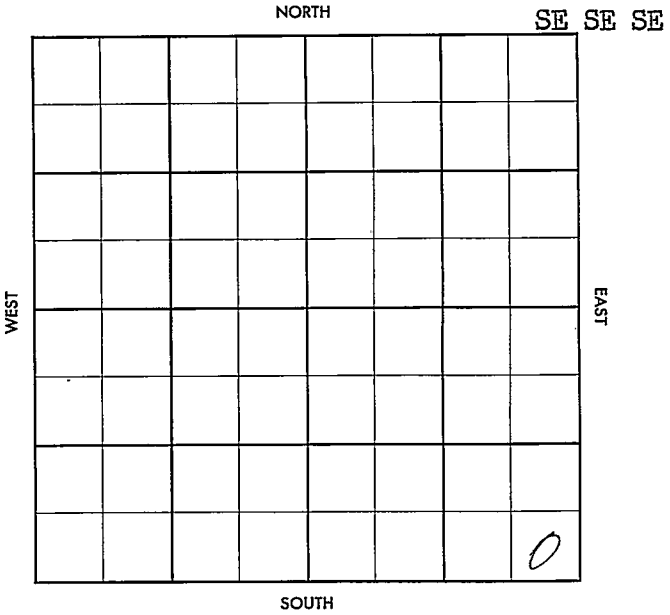

WILDCAT

FORM 513 SUNRAY

County Kangman Elev. _____
Sec. 20 Twp. 27 Rge. 7W
Company Tennessee Gas & Transmission
FarmName Wallace No. 1

TOPS	DEPTH	LOG	DATUM	Loc. in Sec.
Anh.				SE SE SE
Ip.				
H.				
Tr.				
Dg.				
Bl.				
L.				Geol.
K.C.				Contr.
B.K.C.				Virginia
Ce.				Pool
C.				Wildcat
M.				FIRST REPORT APR 24 '57
M.				
K.				
Mz.				
Me.				
V.				
S.				
S.				
A.				
R.				
Pe.				
G.				
T.D.				

Date Comm. MIRT

~~27~~

Co.

Lse.

No.

Sec.

T.

R.

County Kingston Elev. 1608 DF
 Sec. 20 Trip. 27 Rgs. 7W
 Company Tennessee Gas & Transmission
 Farm Name Wallace No. 1

TOPS	DEPTH	LOG	DATUM
Anb.			
Tp.			
H.	2998		
Tr.	3025		
Dg.	3039		
Bt.	1295d 3138		
L.	BW 3230		
K.E.	459 3241		
B.K.C.			
Ce.			
C.			
M.	3945		
M.			
K.			
Mz.			
Me.			
V.	4254		
S.	4281		
S.			
A.	4370		
R.			
PE.			
G.			
T.D.	4395		

Loc. in Sec. 3E SE SE
 Geol. _____
 Concr. _____
 Pool _____
ABANDONED
 MAY 15 '57

Date Comm. _____
 MIRT # 157 4-22-57 8578
 244/145 ID 3025' RST 8 51
 DST 3340-84 1hr 1140' SW
 FP 75-615 BHP 1330 DST
 3946-56 2hrs 6" ^{TSTM} rec 60'
 Md BHP 1430 DST 3956
 -66 op 80" rec 190' MSW + SC.
 oil FP 20-115 BHP 1370 ID
 ahead MAY 15 '57 DST 4259-63

Co.
 L. Sec.
 No.
 Sec.
 T.
 R.

1hr 870' GCMW BHP
1290 DST 4285-4318
1hr 100' MSW BHP 1305

DEA