


KANSAS

Sedgwick

Section 20 Township 27 Range 4-~~W~~

Well No. #1 Alpers

Company Westgate-Greenland & Mallard

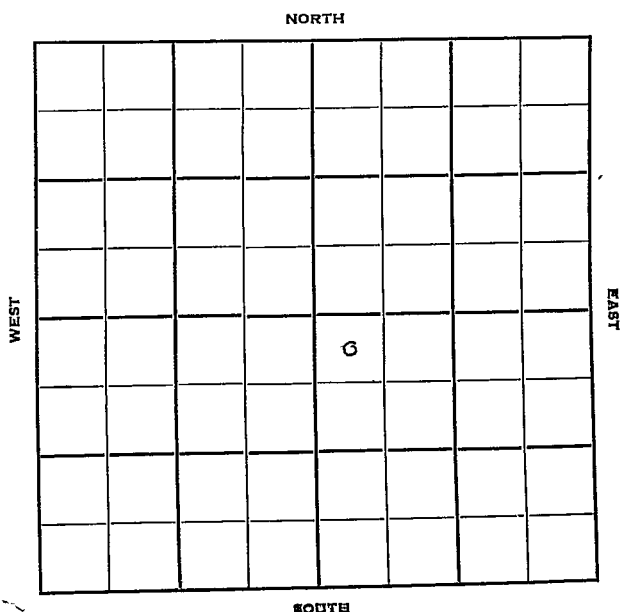

Sec. 20 Twp. 27 R. 4W

Well No. #1 Alpers Farm

Westgate-Greenland & Mallard Company

Contractor

**Bartholomew**


330' Ft. from N. Line

Ft. from S. Line

Ft. from E. Line

330' Ft. from W. Line

NW NW SE

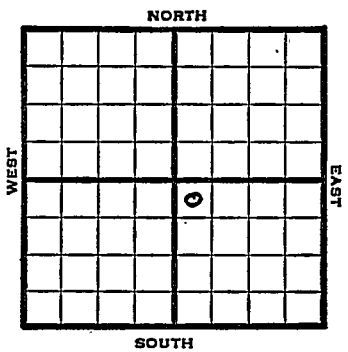

1950

**Elev 1368**

**REPORT**

8/16 Spud 8-15-50  
8" @ 205'  
WOC

8/30 8" @ 205  
Br lime 280 $\frac{1}{4}$  Lans 283 $\frac{1}{4}$   
Miss 3676 DoI 3732  
DST 3730-39 opn 1 hr rec 55' sw  
TD 3739  
D&A

**ABANDONED**



