


Section 20 Township 27 Range 4W

Well No. #1 Bohling

Company L. B. Stableford

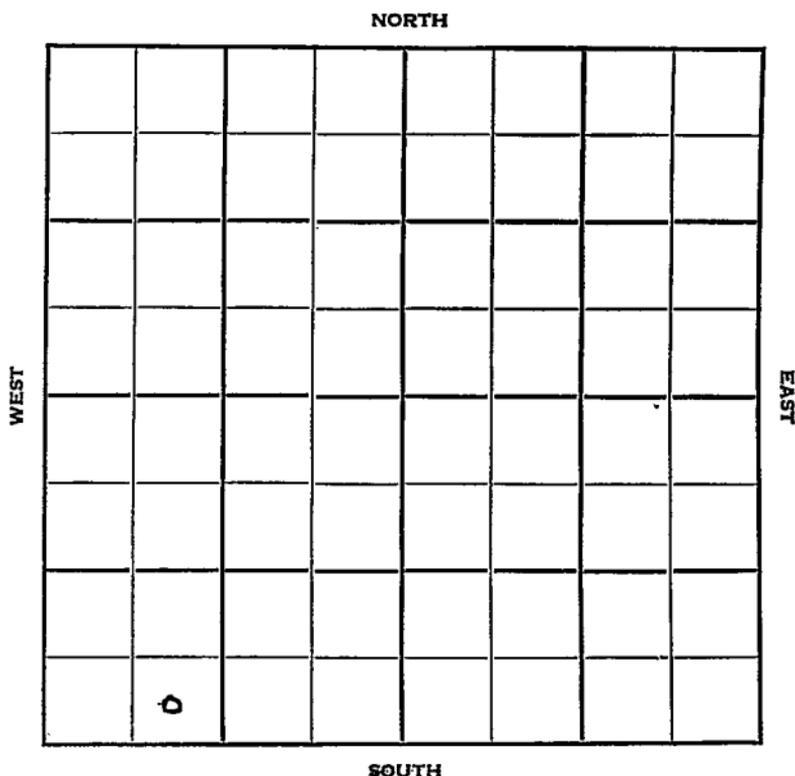

Sedgwick

~~KANSAS~~

Sec. 20

Twp. 27

R. 4W

Well No. #1 Bohling Farm

L. B. Stableford Company

Deek - Contr. Contractor

Bartholomew


Ft. from N. Line

330' Ft. from S. Line

Ft. from E. Line

990' Ft. from W. Line

SE SW SW

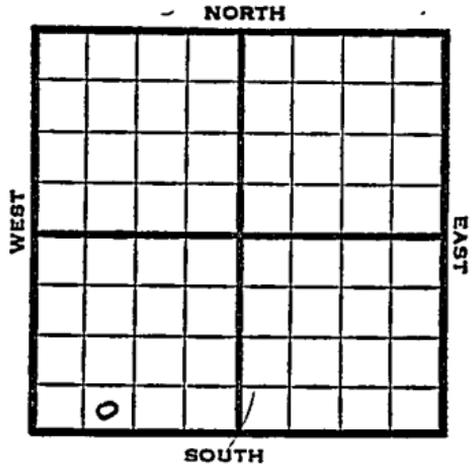

1951

Elev. 1408'

REPORT

11/14

Spud 11-5-51

8" @ 101'

Drlg. 2929'

11/21

Spud 11-5-51

D&A TD 3750

8" @ 101

Miss 3672

DST 3684-3716 open 40 min.

Rec. 12' mud TD 3750

D&A

**ABANDONED**



