


Section 20 Township 27 Range 4-W

Well No. #1 Lentz

Company Huber & Pabco

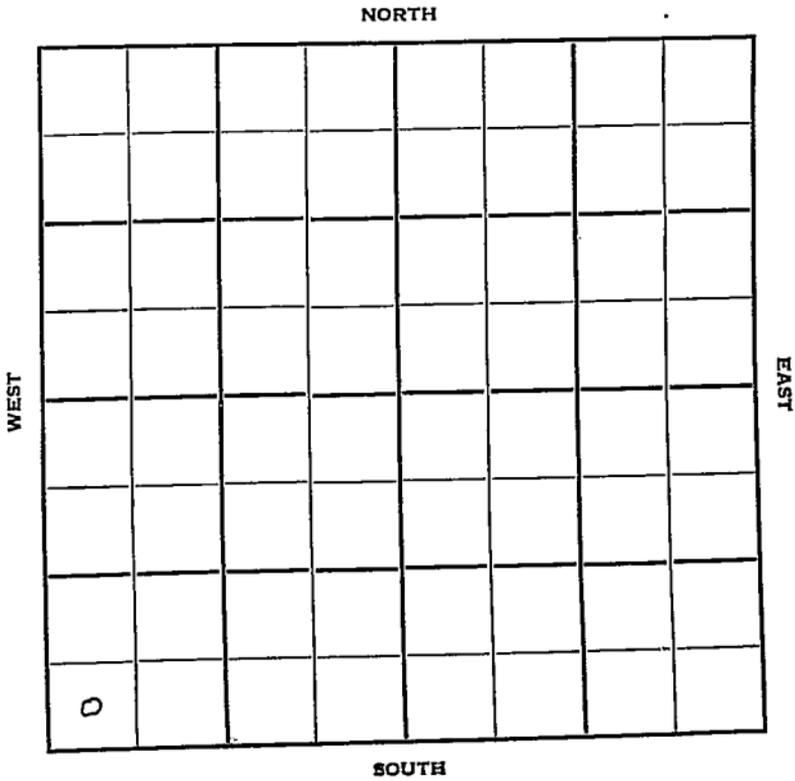

Sec. 20 Twp. 27 R. 4W

Well No. #1 Lentz Farm

Huber & Pabco Company

Pabco Contractor

Bartholomew Pool


 Ft. from N. Line

330' Ft. from S. Line

 Ft. from E. Line

330' Ft. from W. Line

SW SW SW

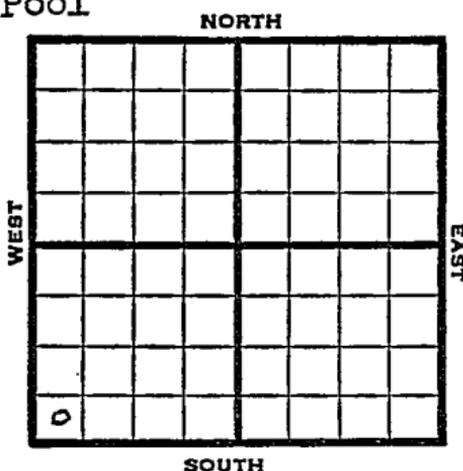

1950

Elev 1424

REPORT

9/6

MIM

10/11

Spud 9-5-50

8 5/8" @ 200

Br lime 2830

Lans 2860

Miss chat 3698

Miss dol 3722

DST 3722-30 opn 1 hr rec 120' o&gcm

TD 3750

5" @ 3722

PB 3730

B/1 bo 8 bw 12 hr

1000 A

35 gw 3 gopd

D&A

ABANDONED

County Sedgwick State Kansas

Sec. 20 (Blk. Twp.) 27 (Sur. Rge.) 4W Map No.

Operator Huber & Pabco

Well No. 3 Farm Lentz

Elev. _____ Location SW SW SW

330 Ft. From S Line SW

330 Ft. From W Line Quarter

Ist. Report SEP 6 1950

Completion _____

Remarks _____

Spudding Date _____

Drlg. Data Bartholomew Pool

M I W

J. E. TYRA


County Sedgwick State Kansas

Sec. 20 (Bk. 27) (Sur. 4W) (Twp. 4W) Map No.

Operator Huber & Pahco

Well No. 1 Farm Lentz

Elev. 1424 Location SW SW SW

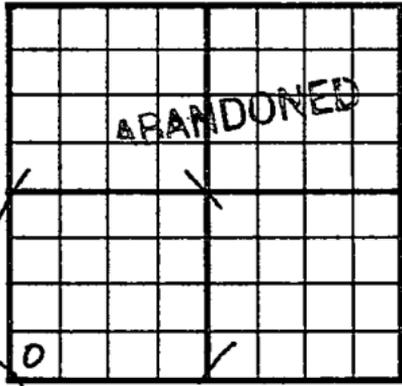

330 Ft. From S Line SW

330 Ft. From W Line Quarter

Ist. Report

Completion OCT 11 1950

Remarks Bartholomew Pool

Pabco Drlg. - Contr.

Spudding Date 9-5-50

Drlg. Data D & A TD 3750

8 5/8" @ 200 Br. lime 2830 Lans. 2860

Miss. chat 3698 Miss. dol. 3722

DST 3722-30 open 1 hr. Rec. 120' o & gcm

TD 3750 5" @ 3722 PB 3730 B/ 1 bo

8 bw 12 hr. 1000 A 35 gw 3 gopd

C. . 35 D & A

J. E. TYRA