


Section 20 Township 27 Range 2 W

Well No. # 1 Siggs

Company Ben Brack

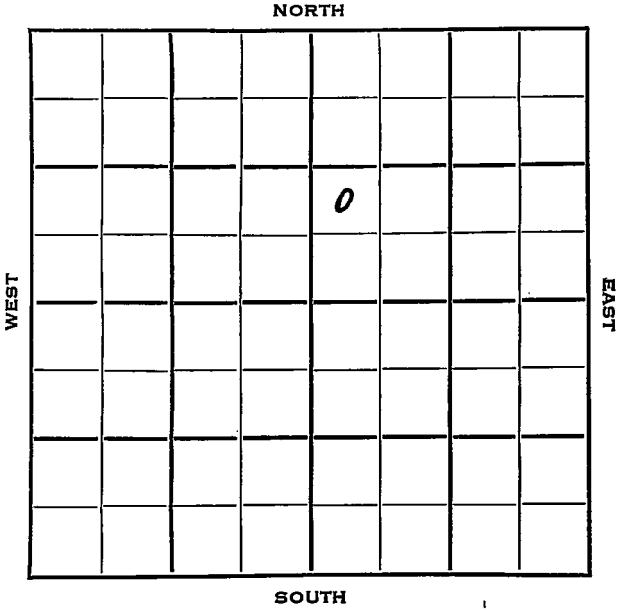

Sedgwick

KANSAS

Sec. 20 Twp. 27 R. 2WWell No. #1 Siggs FarmBen Brack

Company

Brack

Contractor

Wildcat

Ft. from N. Line

990


Ft. from S. Line

Ft. from E. Line

330

Ft. from W. Line

NW SW NE

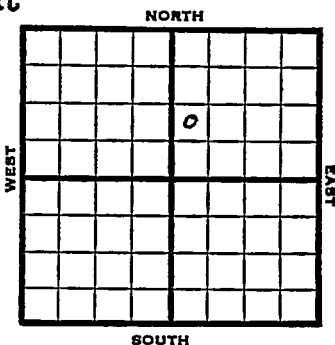

1953

Elev. 1416'

REPORT

8/26

Spud 8-22-53

8" @ 194'

Drlg 1050'

9/2

Lans 2989'

Drlg 3080'

9/9

Miss 3583'

Drlg. 3902'

9/16

Spud 8-22-53

D & A

TD 4230'

8" @ 194'

Lans 2989, Miss 3583, Viola 4078

DST 4079-85 opn $\frac{1}{2}$ hr, rec 3450' wtr

1580# Simp 4094, Arb 4195

TD 4230'

D & A

ABANDONED

County **Sedgewick** State **Kansas**

Sec. 20 (Blk. Twp.) 27 (Sur. Rge.) 2W Map No.

Operator Ben Erack

Well No. **1** Farm **Siggs**

Elev.	Location	NW	SE	NE
-------	----------	----	----	----

FIRST REPORT

990 Ft. From S Line NE

330 Ft. From U Line Quarter

1st. Report **AUG 26, 1953**

Completion

Remarks


Brack - Contr.

Spudding Date 8-22-53

Drlg. Data Wildcat

8" @ 194 drlg. 1050

County Sedgwick State Kansas
 Sec. 20 (Blk.) 27 (Sur.) 2W Map No.
 Operator Ben Brack
 Well No. 1 Farm Siggs
 Elev. 1416 Location NW SW NE

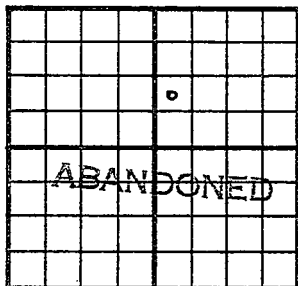

990 Ft. From S Line NE
330 Ft. From W Line Quarter
 Ist. Report
 Completion SFP 1 6 1953
 Remarks Wildcat
Brack - Contr.
 Spudding Date 8-22-53

Drlg. Data D & A TD 4230
8" @ 194 Lans. 2989 Miss. 3583
Viola 4078 DST 4079-85 open $\frac{1}{2}$ hr.
Rec. 3450' wtr. 1580# Simp. 4094
Arb. 4195 TD 4230

D & A